
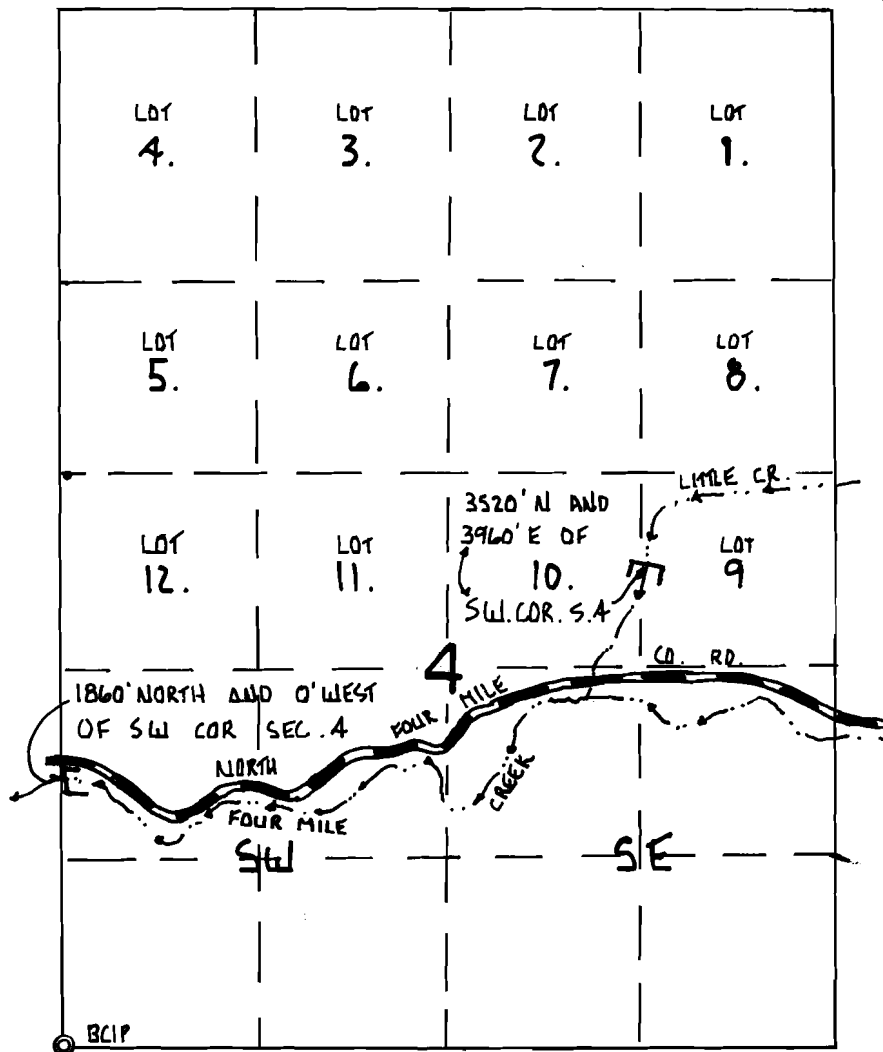


T. 30S. R. 14W. W.M.

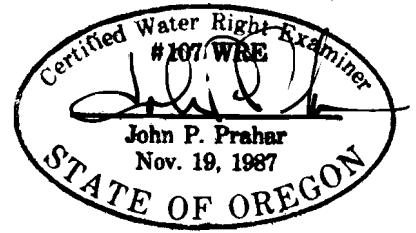

MAP TO ACCOMPANY A SURFACE WATER REGISTRATION STATEMENT  
PRE 1909 VESTED WATER RIGHT CLAIM

PREPARED FOR: J. L. TAYLOR  
P. O. BOX 347  
BANDON, ORE 97411  
(503)347-2317

PREPARED BY: PRAHAR SURVEYING  
1045 BALTIMORE #1  
BANDON, ORE 97411  
(503)347-9517

LEGEND

- Monument as indicated
- ...— Fourmile and Little Creeks
- Limits of stockwatering
- section lines
- 1/4 section lines
- North Fourmile Co Rd. No. 98

DATE OF MAP: DECEMBER 31, 1992

DISCALIMER STATEMENT: This map was prepared for the sole purpose of locating a water right and is not inteded to give legal dimensions of show property ownership lines.