


MAP #1

## HISTORICAL RECORDS OF DEVELOPMENT:


SECTION FORTY 1882 610 HOMESTEAD WATER SURVEY			1992 IRRIGATED ACRES		
		PATENTED	CLAIMED	CARTER CR.	SPRING CR.
8	NENE	FIELD 1890	1882	29.1	3.0
5	SESE	FIELD 1890	1882	25.9	
5	NESE	" 1890	1882	16.0	
5	SENE	" 1924		9.6	
4	NWSW	FIELD 1890	1882	16.1	9.1
4	SWNW	" 1890	1882	22.1	11.2
4	NWNW	" 1890	1882	25.1	12.0
4	NENW	" 1890	1882	1.2	1.2
33	SWSW	" 1890	T. 465. 1882	29.2	4.3
33	SESW	" 1890	1882		20.0

RECEIVED  
JAN 11 1992  
RESOURCES  
MOUNTAIN VIEW

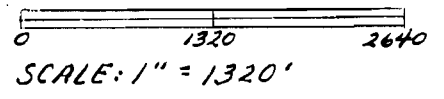

S.32 & S.33 233.9 ACRES TOTAL

NOTE:  
THE INFORMATION SHOWN ON THIS MAP IS SOLELY FOR WATER RIGHTS PURPOSES. DATA SHOWN DOES NOT REPRESENT OWNERSHIP INFORMATION.

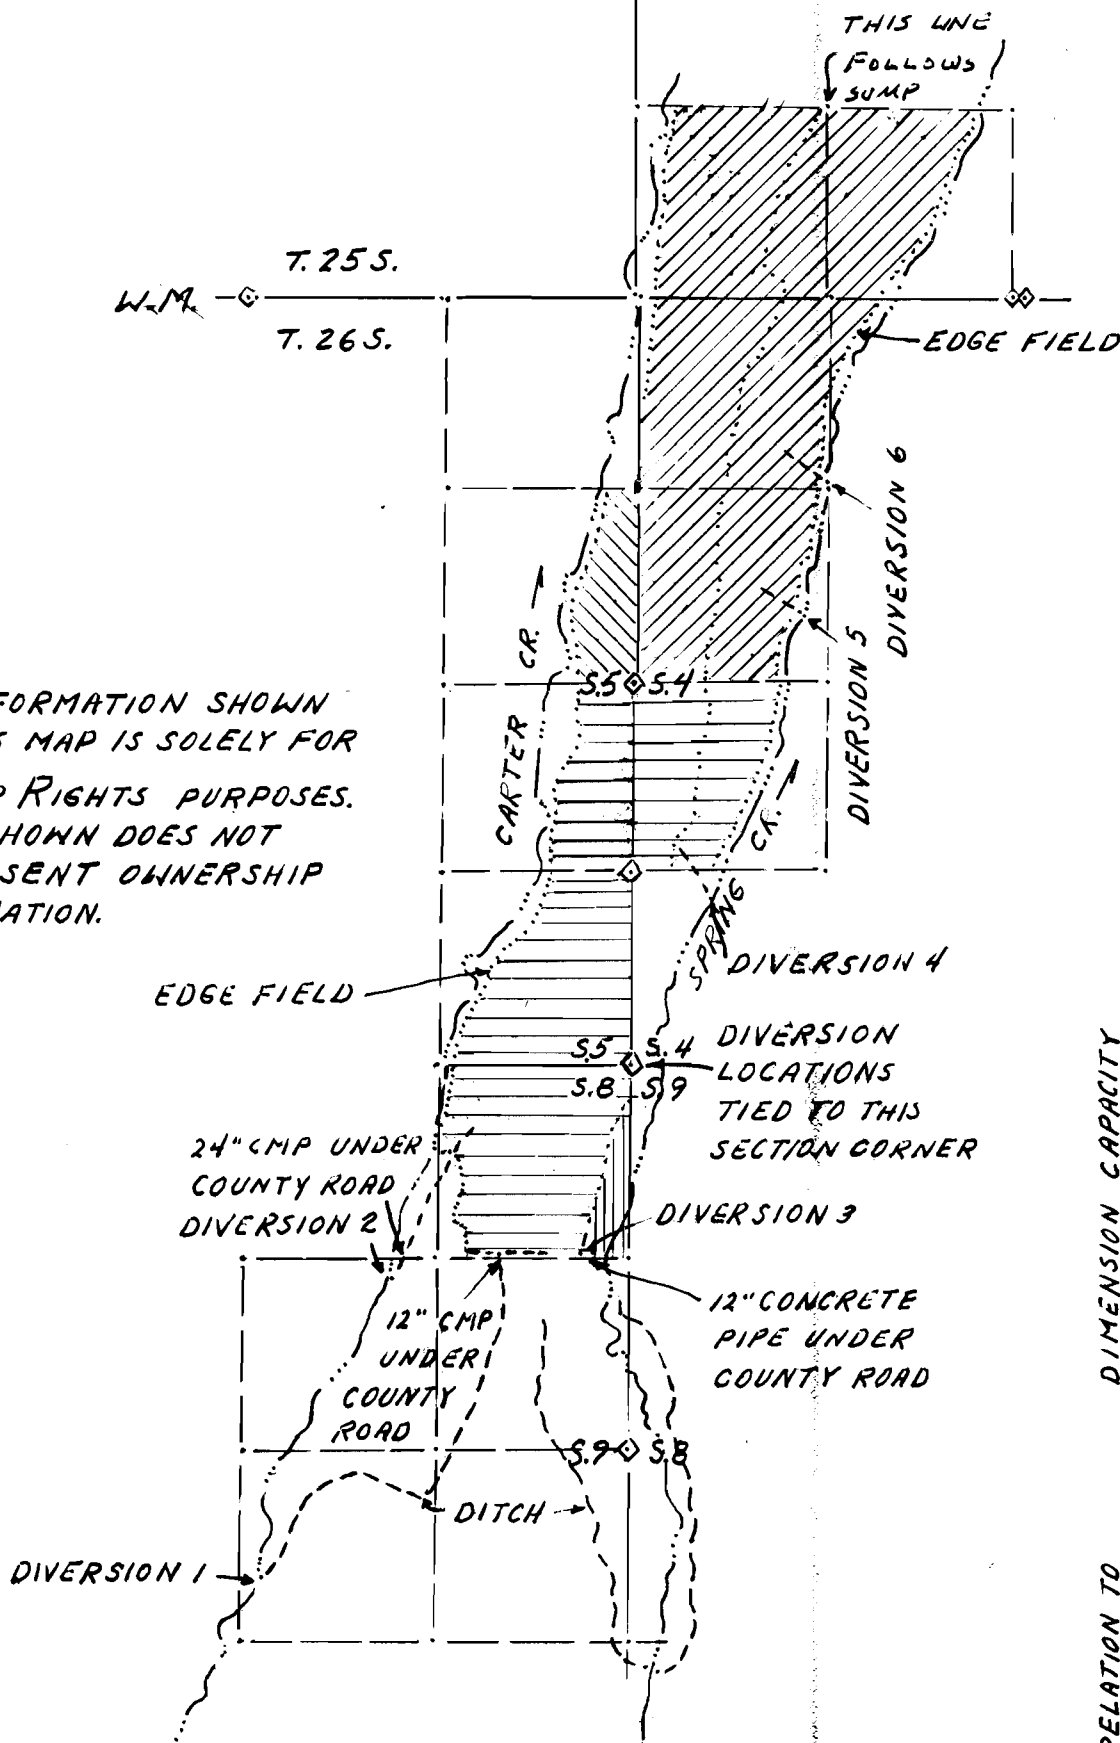

DIVERSION	RELATION TO SECTION CORNER 4-5-B-9	FEET NORS FEETE OKW	DIVERSION CAPACITY	CFS
1		3488' S, 2551' W	12" CMP	1.4
2		1422' S, 1673' W	24" CMP	14.0
3		1271' S, 360' W	12" CCP	1.4
4		1160' N, 539' E	DITCH 1'x3'-1'	5.5
5		3133' N, 1153' E	12" CCP	3.6
6		4013' N, 1347' E	DITCH 2'x2'	13.0

**OWNER:**

JOANNE STITZEL  
3230 STITZEL ROAD  
JORDON VALLEY, OR 97910  
(503) 586-2360

SURVEY BY: DAVID L. HADDOCK  
DATE: OCT. TO DEC. 1992  
56 NE MT. HEBRON  
PENDLETON, OR 97801

