

# PRE-190 VESTED WATER RIGHT

Section 36 Township 24S Range 11W W.M.

Coos County


S1/16  
Sec. 25

RECEIVED

MAY 1997

RESOURCES DEPT.  
A. M. OREGON

Scale 1" = 400 Feet

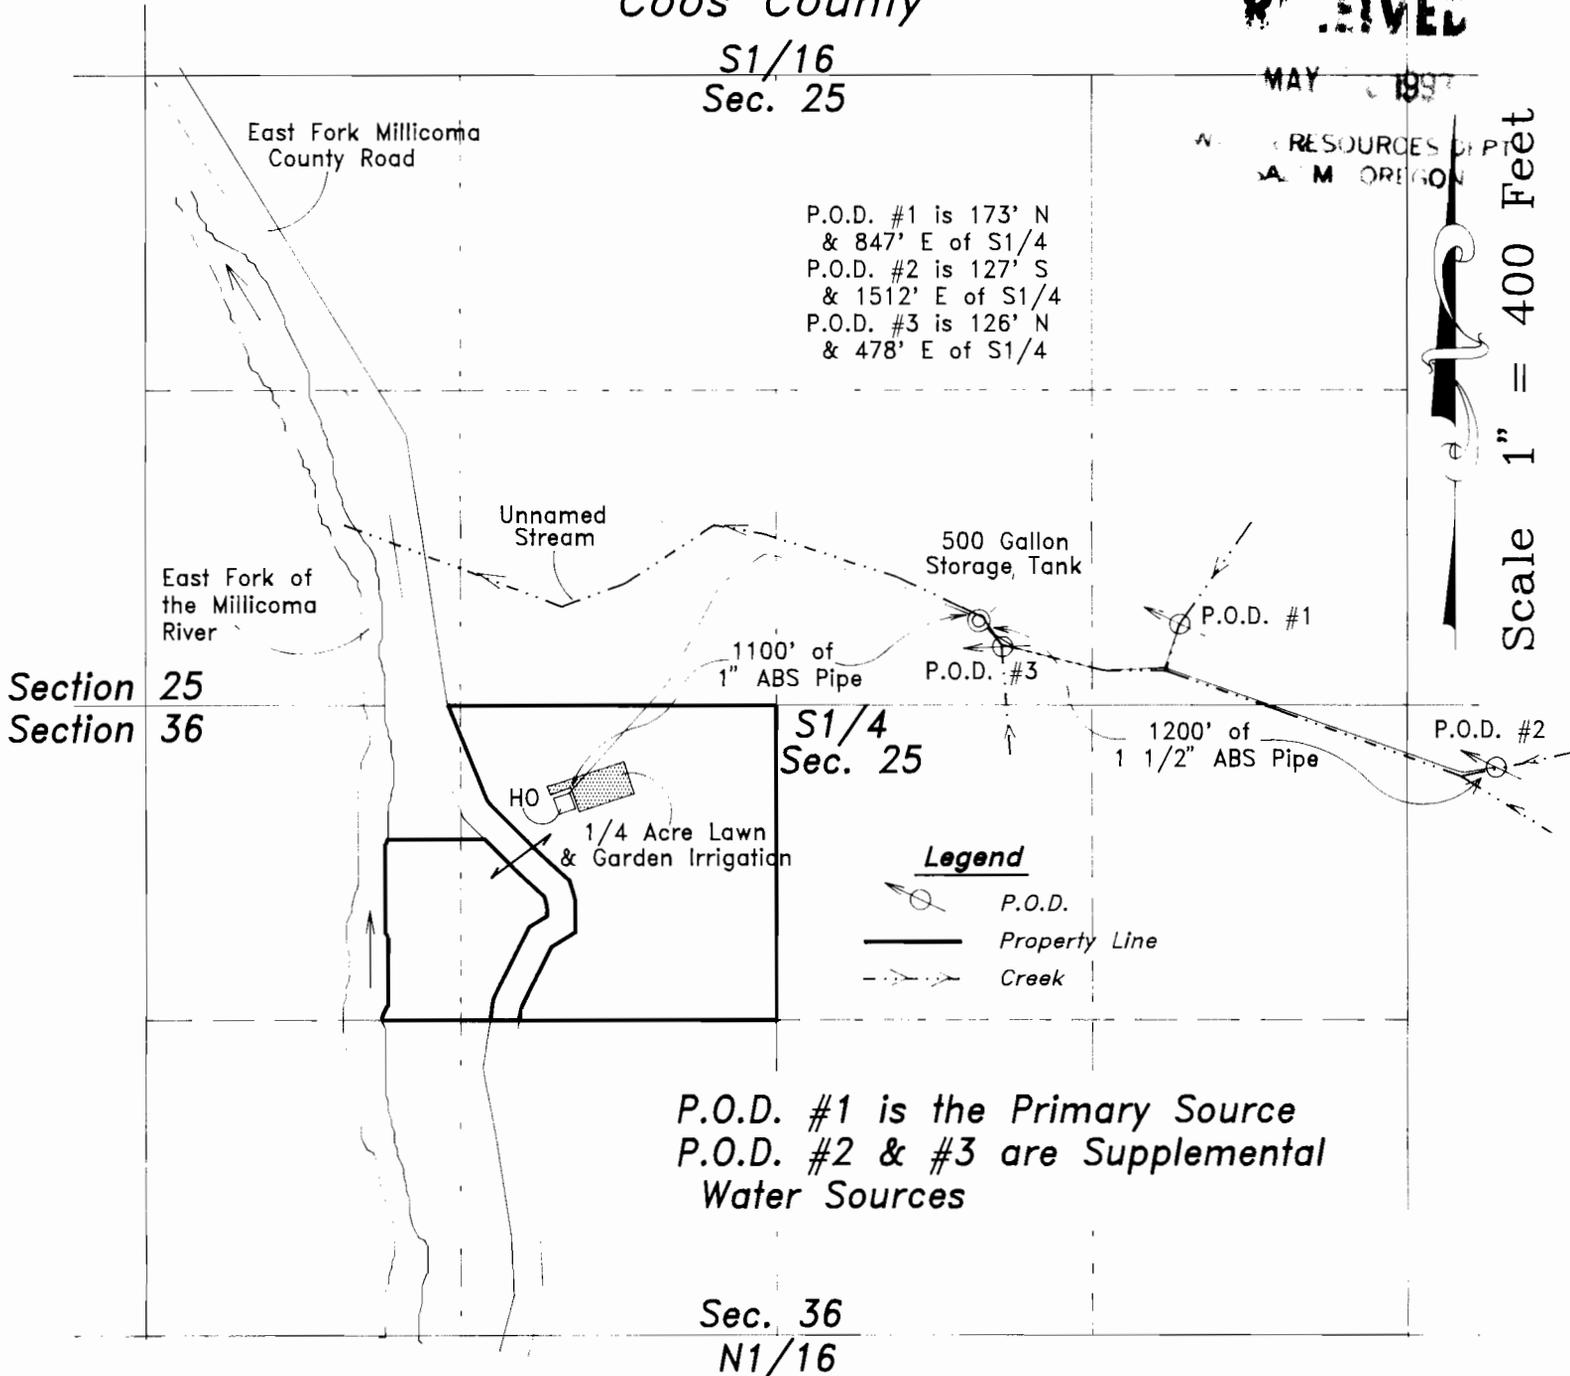

IN THE NAME OF  
Ray & Dollie Austin



Surveyed on April 17, 1993 by R.E. Stuntzner

Prepared By  
Stuntzner Engineering  
P.O. Box 118  
Coos Bay, Oregon 97420

### EXAMINERS DISCLAIMER STATEMENT

The preparation of this map was for the purpose of identifying the location of the Water Right only and has no intent to provide dimensions or location of property ownership lines.