

T. 29 S., R. 12 W. Sec. 4


Map For a pre-1909 Surface Water Registration.

Scale: 1" = 400'

Survey Date: Apr. 24, 1993, and

This map is not the result of a property survey ¹²⁻³⁰⁻⁹³
and is not to be used as such.


For: Leila Roček File # SWR-485.

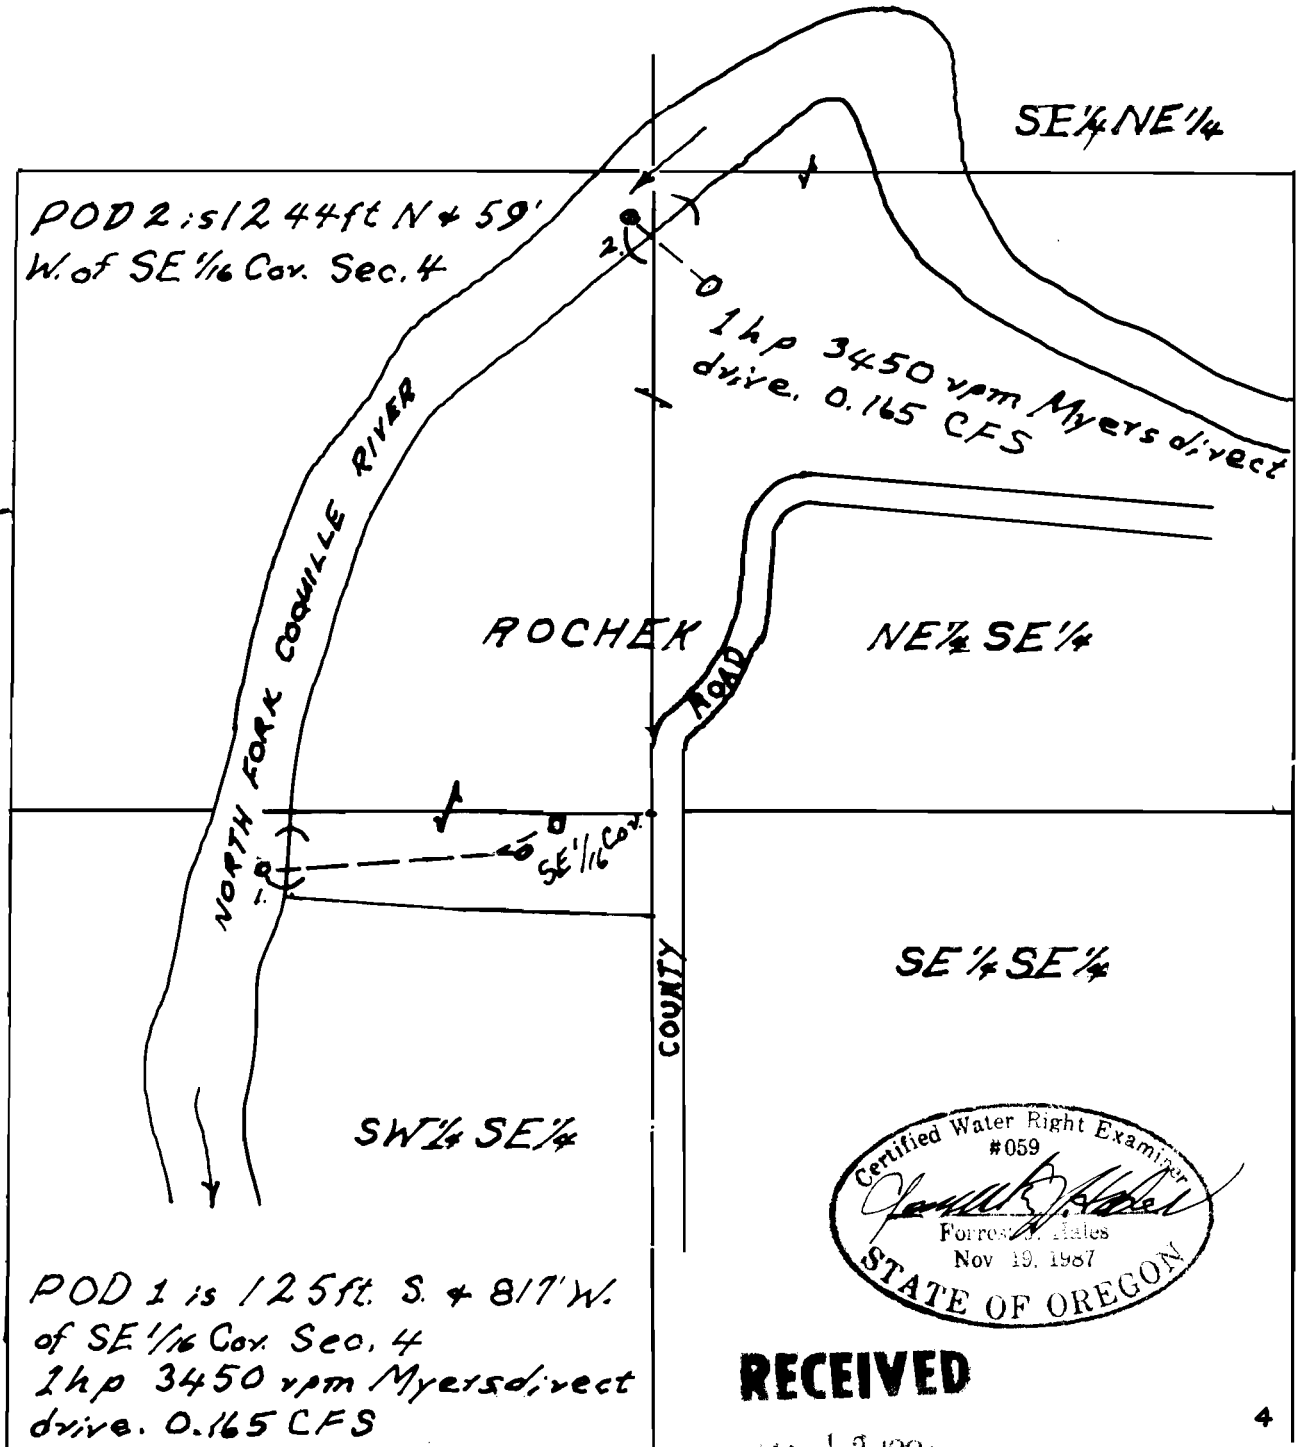

POD 2 is 1244ft N + 59'
W. of SE 1/6 Cor. Sec. 4

1 hp 3450 rpm Myers direct
drive, 0.165 CFS

POD 1 is 125ft S. + 817' W.
of SE 1/6 Cor. Sec. 4
1 hp 3450 rpm Myers direct
drive, 0.165 CFS

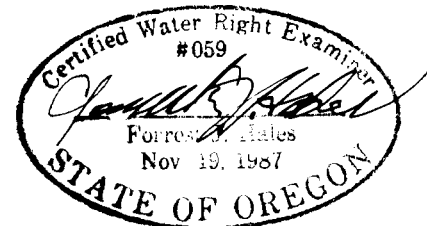

RECEIVED

JAN 12 1994
WATER RESOURCES DEPT
SALEM, OREGON

4 3
9 10