


T 32 S R 15 W W.M.

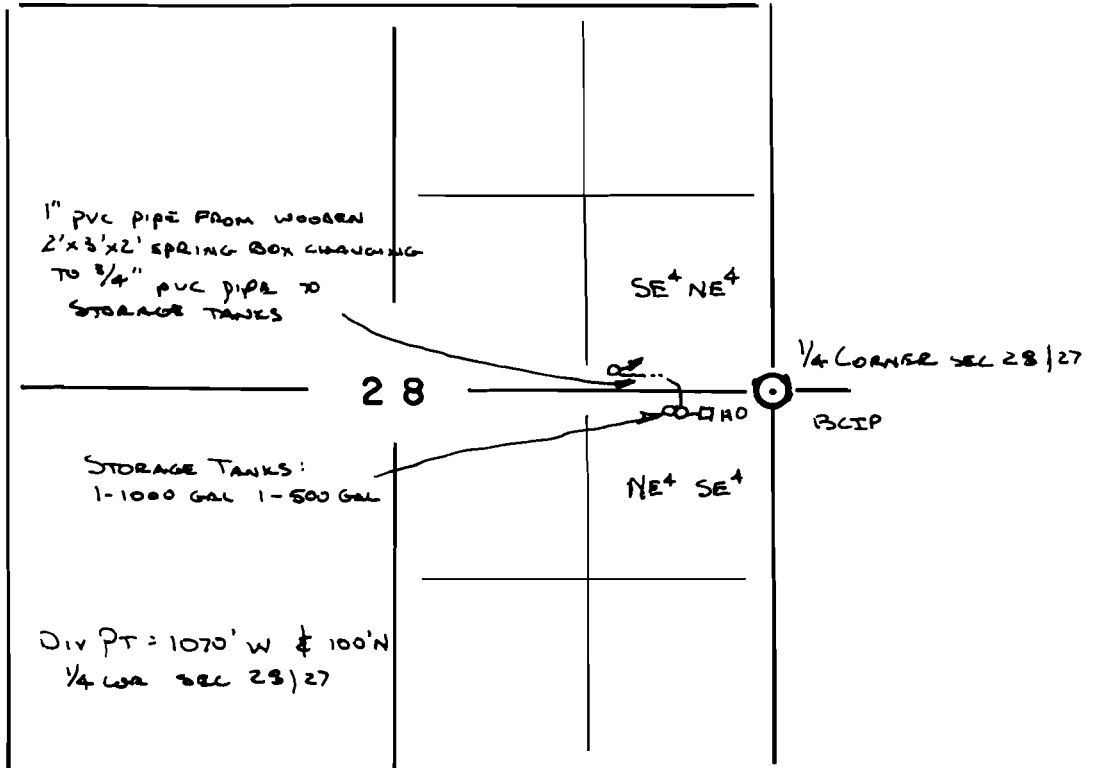

scale 4" = 1 mile

FINAL PROOF SURVEY

UNDER

S.W.R. - 49

Application No. Permit No.

IN NAME OF

Frances White

Surveyed Aug 1991, by CWRE-107