

T 29 S. R. 12 W. Sec. 1


Map for a pre-1909 Surface Water Registration

Scale: 1" = 1320ft.

Date of Survey: 3-18-93

This map is not the result of a property survey and is not to be used as such.

Applicant: **DUANE L. BUSE**

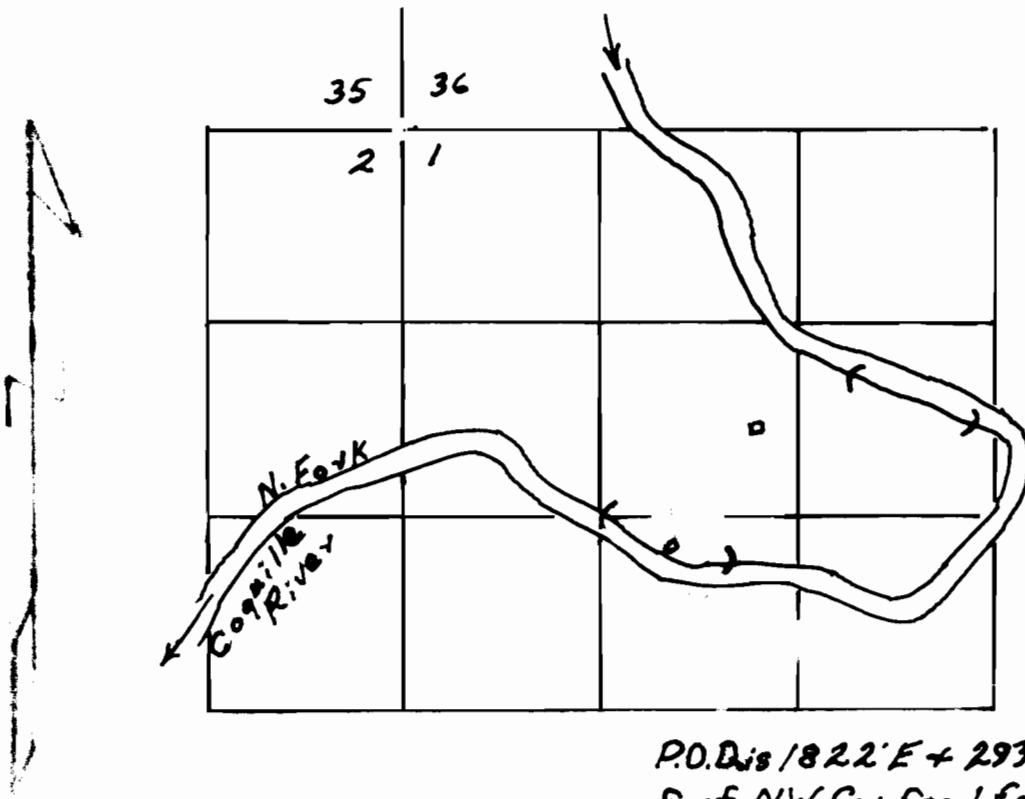

P.O. Dis 1822' E + 2930'
S. of NW Cor. Sec. 1 for
Permit No. 29323.

Application No.
Permit No.

