


T.6 S. R. 4 W. W.M.

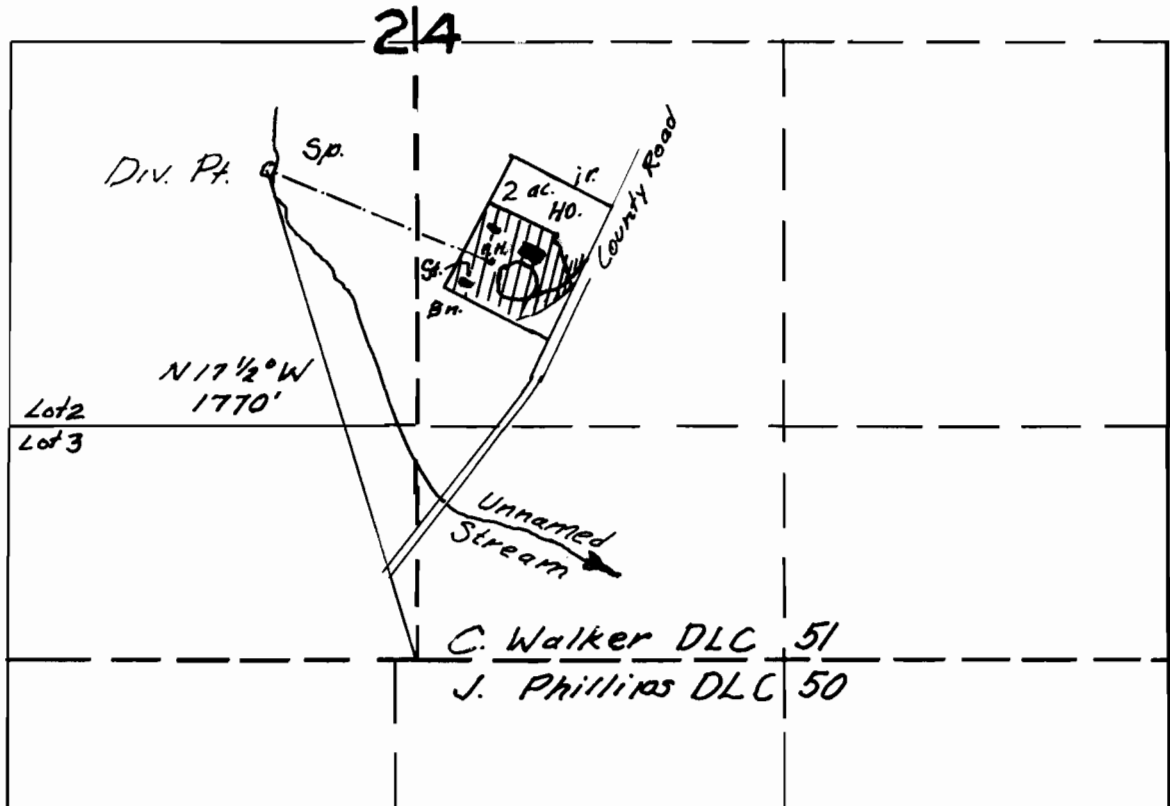

Scale: 1" = 660

MAP FOR REGISTRATION STATEMENT
CLAIM OF RIGHT TO APPROPRIATE
SURFACE WATER OF
BYRON J. PURVINE

FEB. 20, 1989

JUNE 8, 1989

By

Chris L. Wheeler