


394.7 ACRES
TOTAL

SUCCOR CR.

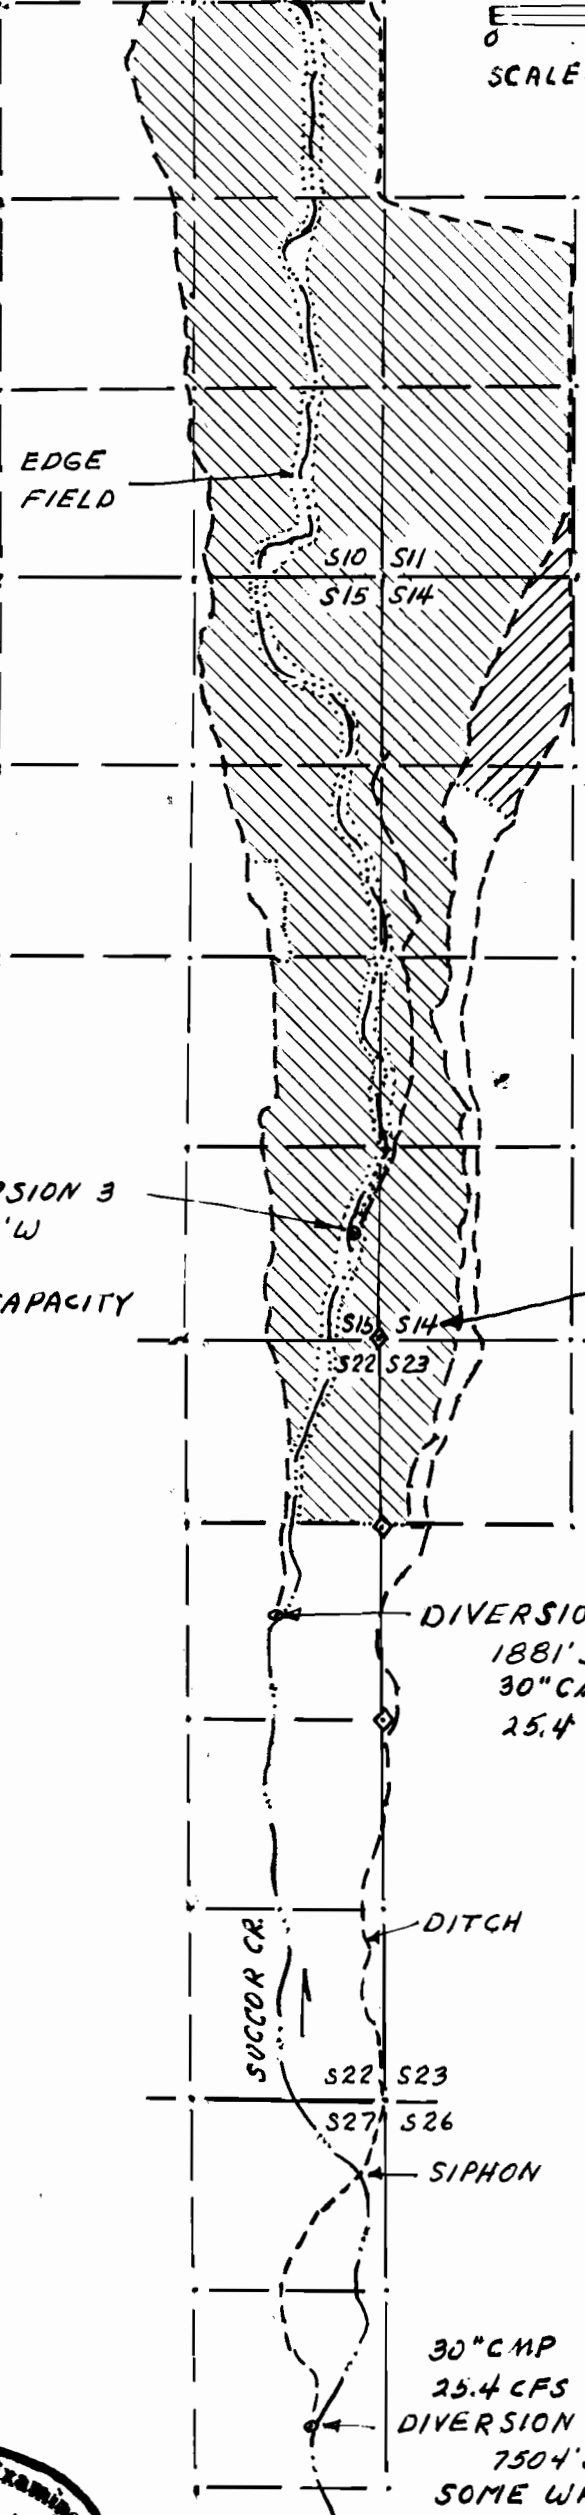

DIVERSION 3
734' N, 185' W
30" CMP
25.4 CFS CAPACITY

DIVERSION TIES
N-S-E-W ARE
ALL TO THIS
CORNER

DIVERSION 2
1881' S, 697' W
30" CMP
25.4 CFS CAPACITY

30" CMP
25.4 CFS CAPACITY
DIVERSION 1
750' S, 482' W
SOME WATER ALSO DITCHED
TO IRRIGATE PART OF 240
ACRES IN SECTIONS 1 AND 2
OF T. 26 S., R. 46 E., W. 11.

*F = FIELD, ID = IRRIGATION DITCH

HISTORICAL RECORD OF DEVELOPMENT:

SECTION	FORTY	SURVEY	PATENT	1882 GLO	1899	1992 IRRIGATED ACRES
10	SWNE	ID	1910	WATER CLAIMED	10.5	SUCCOR CREEK
	SENE	ID	1889		35.3	
	NWSE	ID	1910		2.5	
	NESE	ID	1889		35.6	
	SWSE		1910		0.1	
	SESE	F, ID	1889		32.6	
11	NWSE	F	1889		36.6	
	SWSW	F	1889		38.0 + 2.0 NEW	
14	NWNE	F	1889		22.4 + 15.7 NEW	
	SWNW	F	1899		12.0 + 2.7 NEW	
	NWSE	F	1891		11.4	
	SWSW	F	1891		16.2	
15	SENE	F, ID	1899		32.1	
	SENE	F	1899		22.3	
	NESE	F, ID	1891		22.1	
	SESE	F, ID	1891		18.4	
22	SENE	F, ID	1891		16.0	
23	NWNE	F	1891		10.2	

NOTE: THE INFORMATION SHOWN ON THIS MAP IS SOLELY FOR WATER RIGHTS PURPOSES. DATA SHOWN DOES NOT REPRESENT OWNERSHIP INFORMATION.

OWNER:
MACKENZIE RANCHES
410 SUCCOR CR. ROAD
JORDAN VALLEY, OR 97910
(503) 339-3229

SURVEY BY: DAVID HADDOCK
56 NE MT. HEBRON
PENDLETON, OR 97801
DATE: DEC. 1992

