


Section 25&26 Township 23S Range 12W W.M.
 Coos County

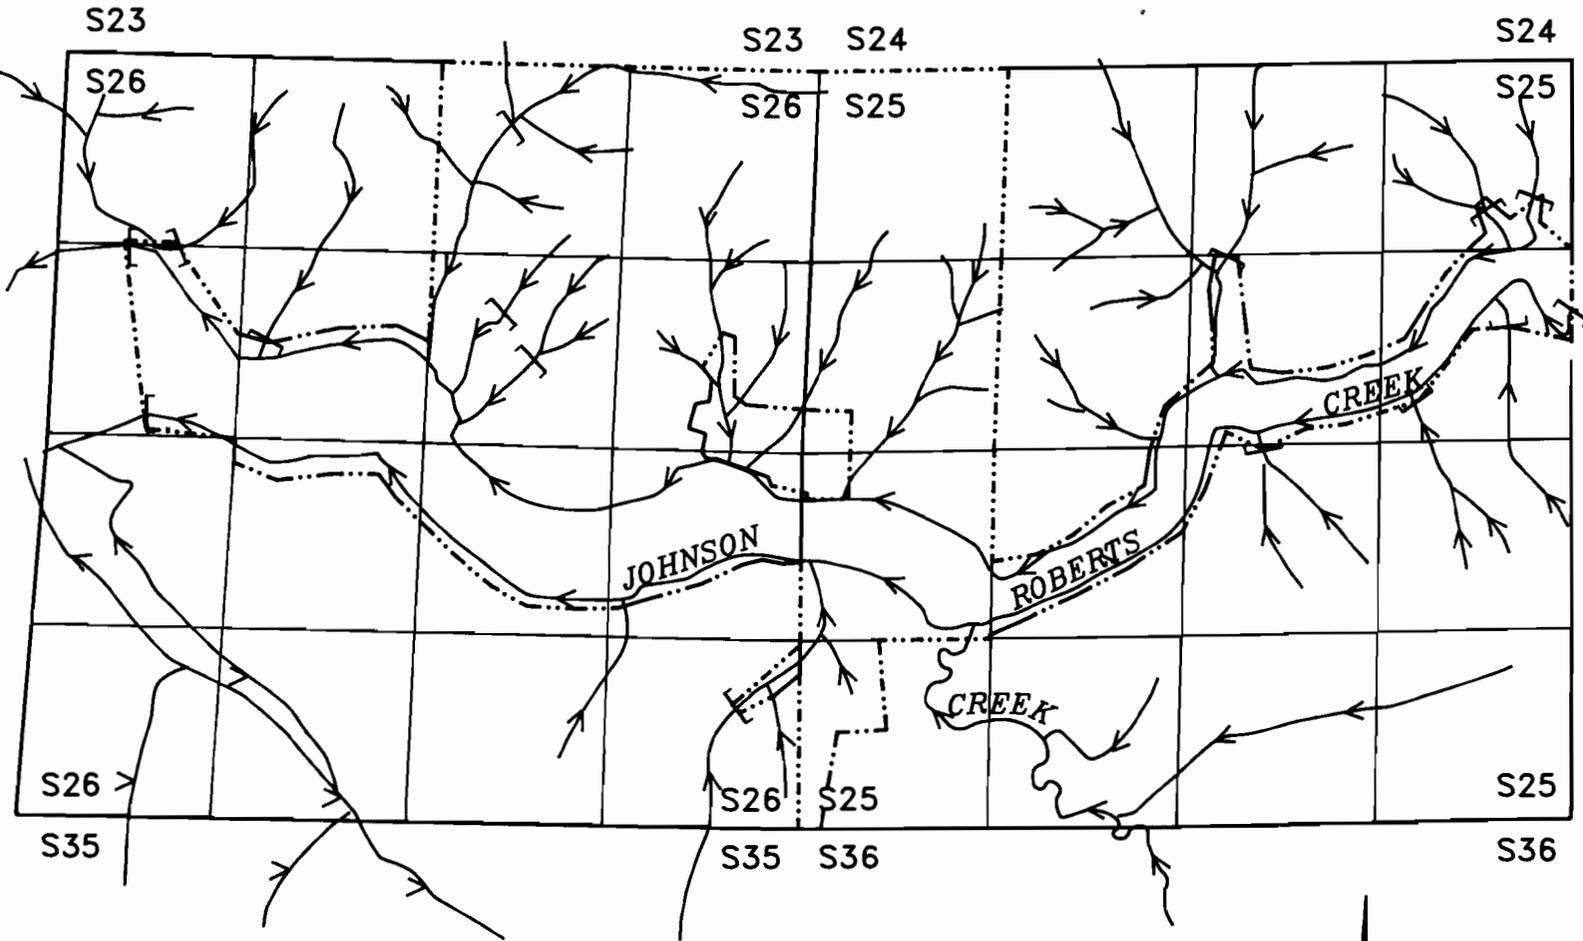

- Legend**
- Property Line
 - Creek
 - [] Stock Watering

Scale 1" = 1320'

EXAMINERS DISCLAIMER STATEMENT

The preparation of this map was for the purpose of identifying the location of the Water Right only and has no intent to provide dimensions or location of property ownership lines.

PRE 1909 VESTED WATER RIGHTS SURVEY
 IN THE NAME OF
Joe Monson

Certified Water Right Examiner
 #142
Harvey Wilcox
 Harvey Wilcox
 Nov. 19, 1987
 STATE OF OREGON
 EXPIRES 12/31/94

Surveyed on January 11, 1993 by H.A. Wilcox