
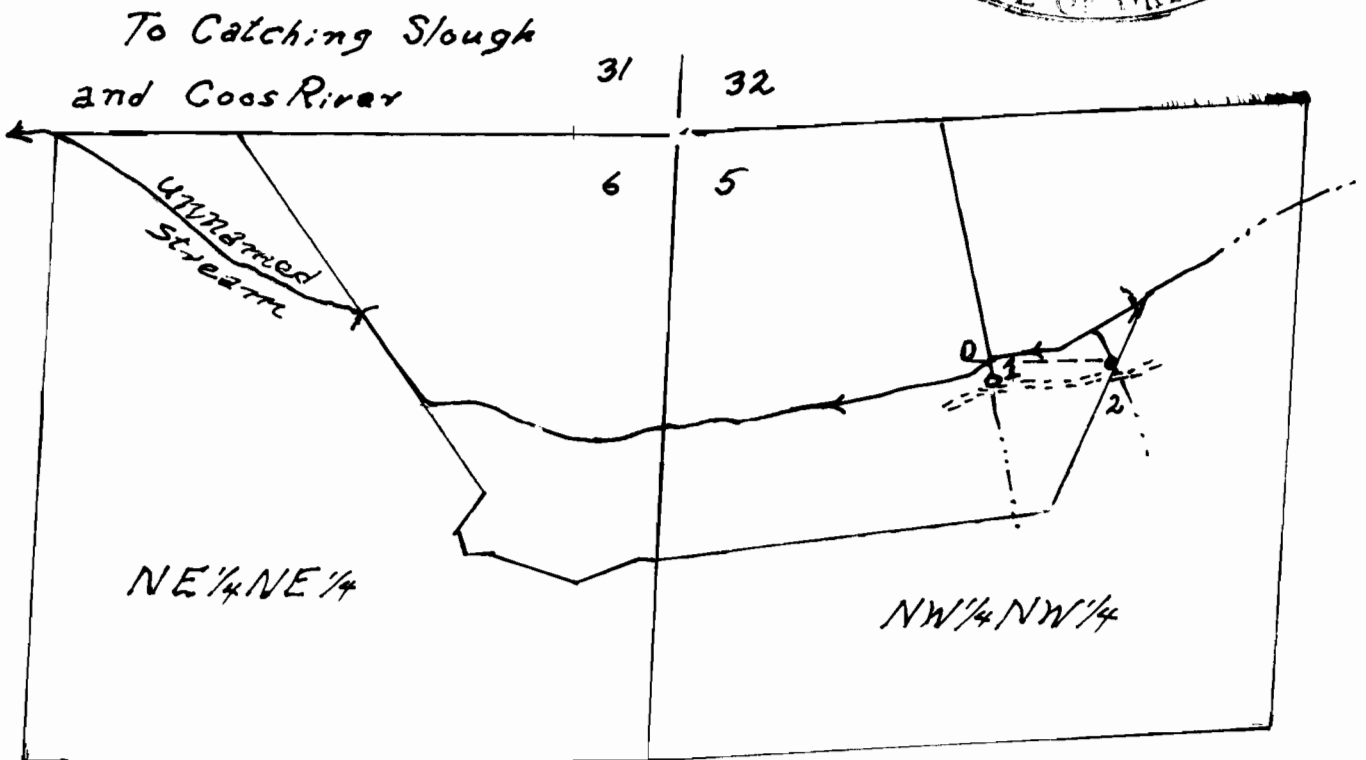


T. 26 S., R. 12 W. Sec. 5 & 6
 Map for a pre-1909 Surface Water Registration.
 Scale: 1" = 400ft. Surveyed June 23, 1993.
 This map is not the result of a property survey and
 is not to be used as such.

Applicant: Richard L. Heaney SWR. 511.
 Riparian area stockwatering shown ()

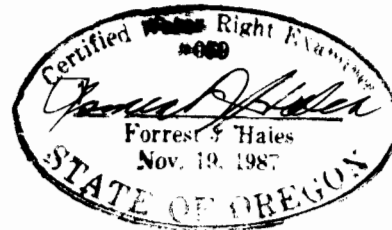

P.O.D 1 is 510' S. and 662' E. of NE Cor. Sec. 6
 P.O.D 2 is 475' S. and 910' E. of NE Cor. Sec. 6
 All Coordinates were determined from Photo
 No. 0-86-ACBC 9-19A-61