


# PRE-190<sup>a</sup> VESTED WATER RIGHT

The NE1/4 and portions of the NE1/4 of the SE1/4 of  
 Section 01 Township 29S Range 13W W.M.  
 Coos County

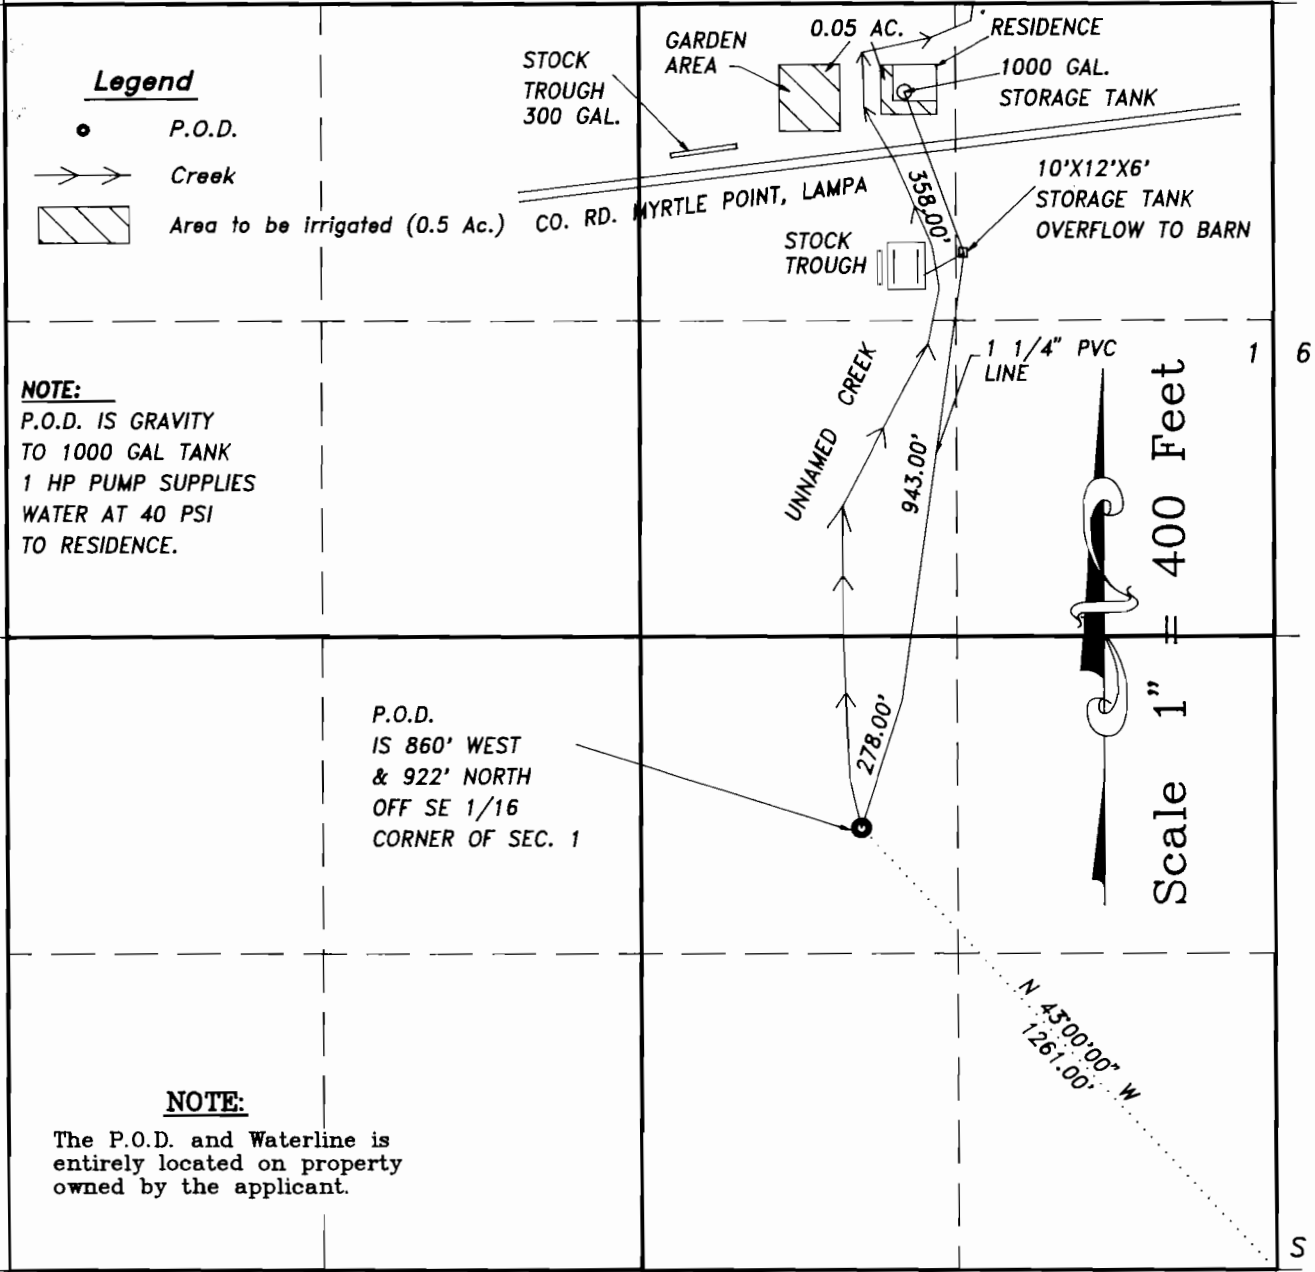

IN THE NAME OF  
 LOUIS McCARTHY

Surveyed on SEPTEMBER 21, 1993 by DENNIS GOUDE

**EXAMINERS DISCLAIMER STATEMENT**

The preparation of this map was for the purpose of identifying the location of the Water Right only and has no intent to provide dimensions or location of property ownership lines.

