


PRE-190 VESTED WATER RIGHT

Section 05 Township 26S Range 12W W.M.
Coos County

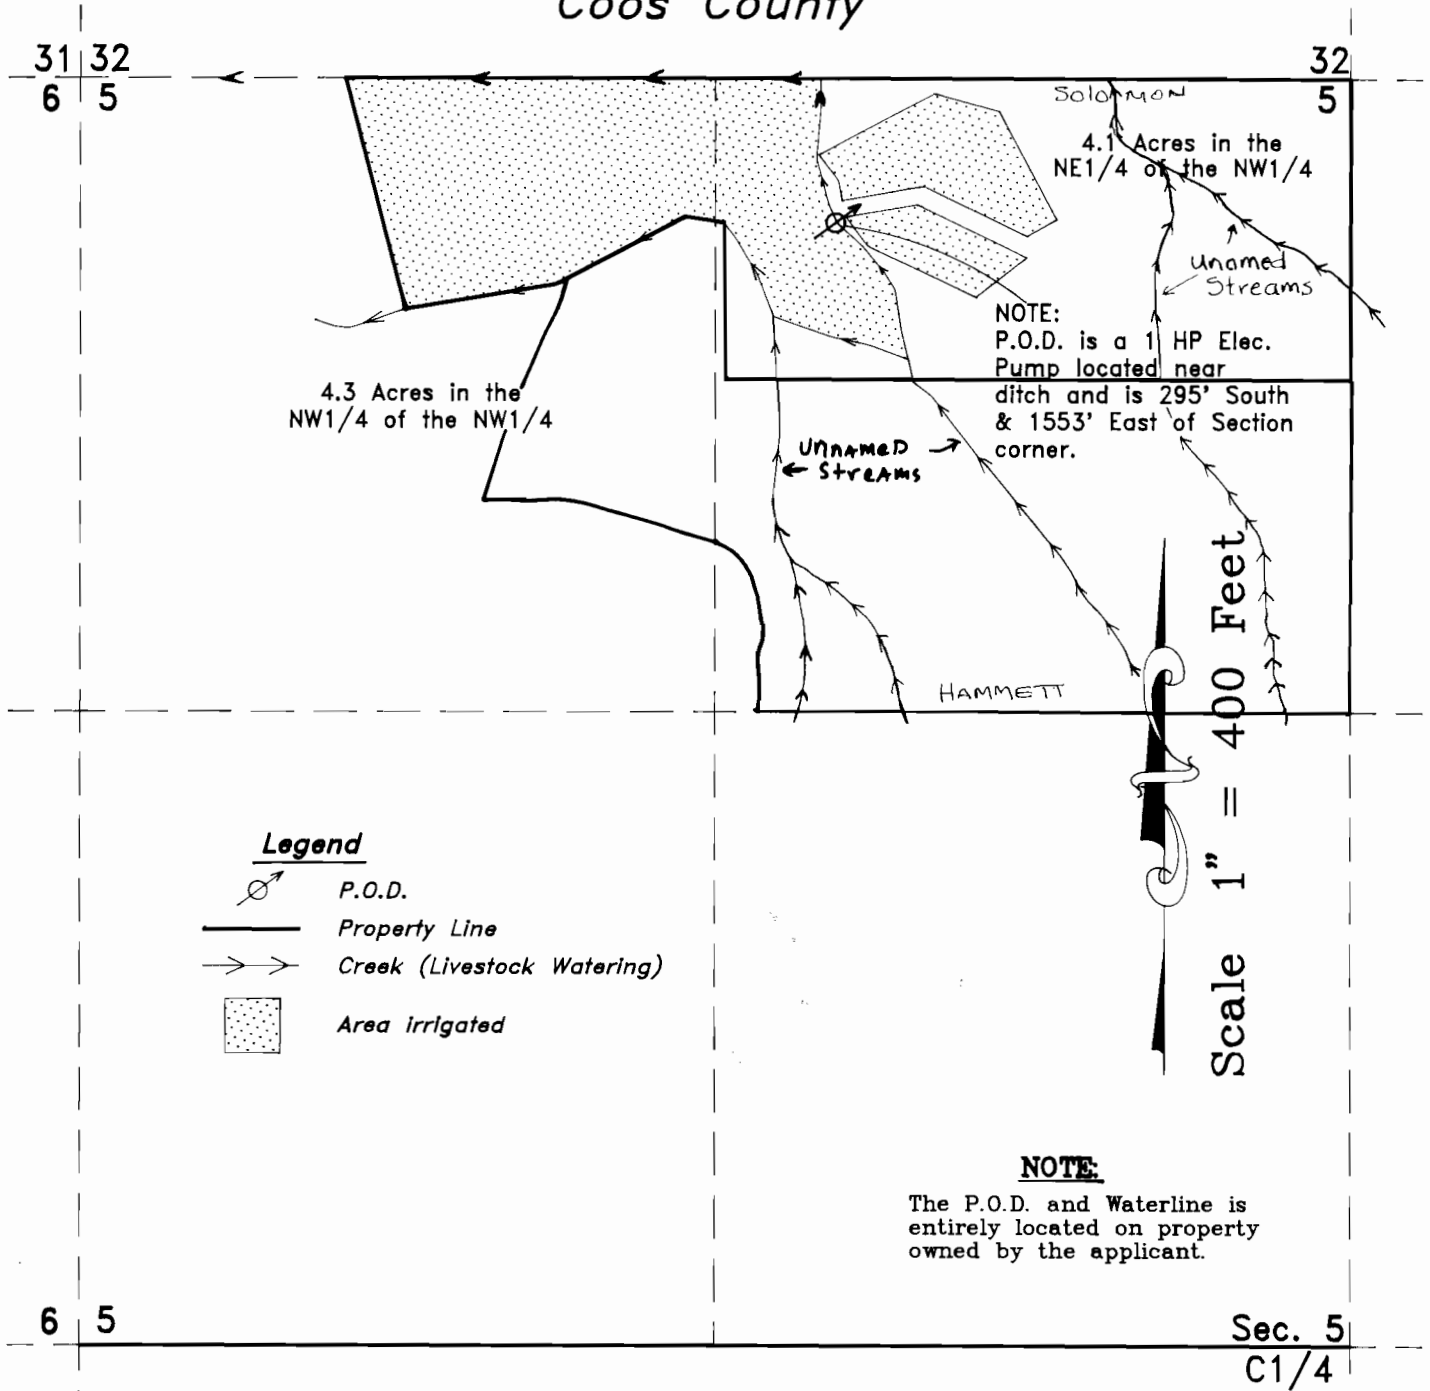


IN THE NAME OF

Stanley Solomon & Gerald Hammett

Surveyed on July 14, 1993 by R.E. Stuntzner

EXAMINERS DISCLAIMER STATEMENT

The preparation of this map was for the purpose of identifying the location of the Water Right only and has no intent to provide dimensions or location of property ownership lines.

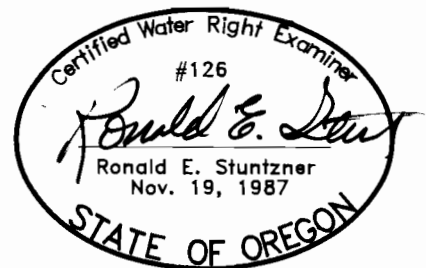

SWR-523