

RECEIVED

APR 14 1994

WATER RESOURCES DEPT.
SALEM, OREGON


SURFACE WATER REGISTRATION #527

PHIL STRADER ESTATE
DYRMA STRADER ESTATE

SECTION 8, TOWNSHIP 26 SOUTH, RANGE 3 WEST, W.M.



1 INCH = 1320 FEET

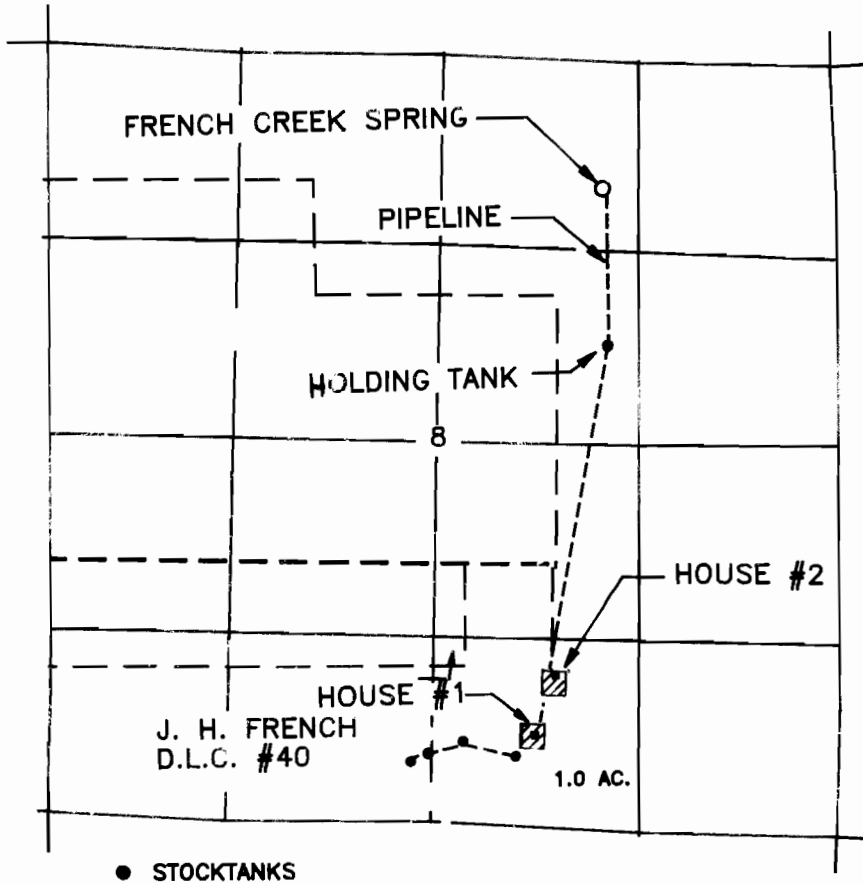

FRENCH CREEK SPRING IS LOCATED 850 FEET SOUTH AND 1530 FEET WEST FROM THE NORTHEAST CORNER OF SECTION 8, BEING WITHIN THE NW 1/4 NE 1/4 OF SECTION 8, TOWNSHIP 26 SOUTH, RANGE 3 WEST, W.M., DOUGLAS COUNTY.

THE PURPOSE OF THIS MAP IS TO IDENTIFY THE LOCATION OF THE WATER RIGHT. IT IS NOT INTENDED TO PROVIDE INFORMATION RELATIVE TO THE LOCATION OF PROPERTY OWNERSHIP BOUNDARY LINES.

SWR-527