



TOWNSHIP 6 SOUTH, RANGE 1 EAST, W.M.
 Sections 22 & 27

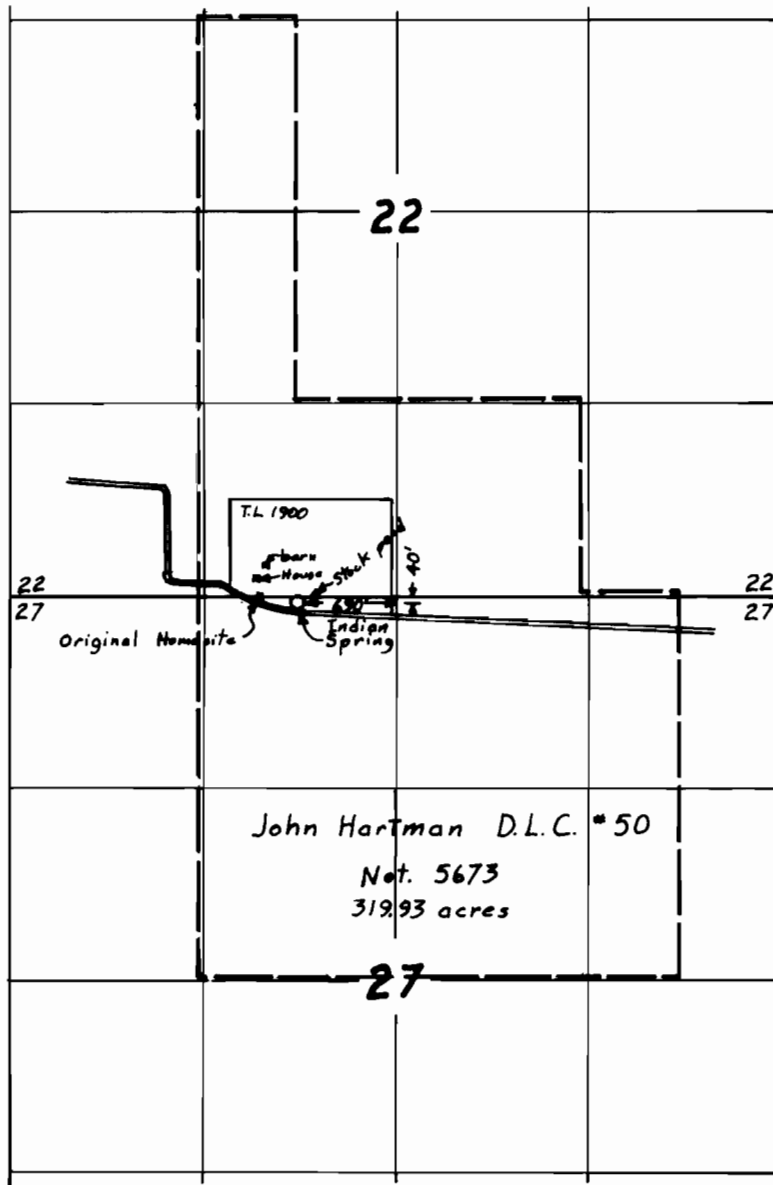

Scale 1" = 1320'

Registration Map
 for
BARBARA B. SPINOLA

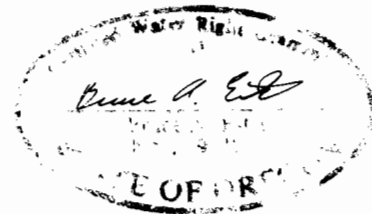

Surveyed Nov. 19, 1991

This map is for the purpose of locating a water right only and has no intent to provide the location of property lines or legal dimensions.