

RECEIVED

T.28S. R.13W. W.M.


COUNTY OF COOS, STATE OF OREGON

PREPARED FOR: HENRY AND MARILYN ISENHART
RT. 1 BOX 3185
COQUILLE, OREGON 97423
(503)396-2655


PREPARED BY: PRAHAR SURVEYING
WATER RESOURCES DEPT.
1045 BALTIMORE #1
SALEM, OREGON
BANDON, OREGON 97411
(503)347-9517

MAP TO ACCOMPANY A SURFACE WATER REGISTRATION STATEMENT
PRE 1909 VESTED WATER RIGHT CLAIM

DECEMBER 29, 1992
REVISED 2/20/95

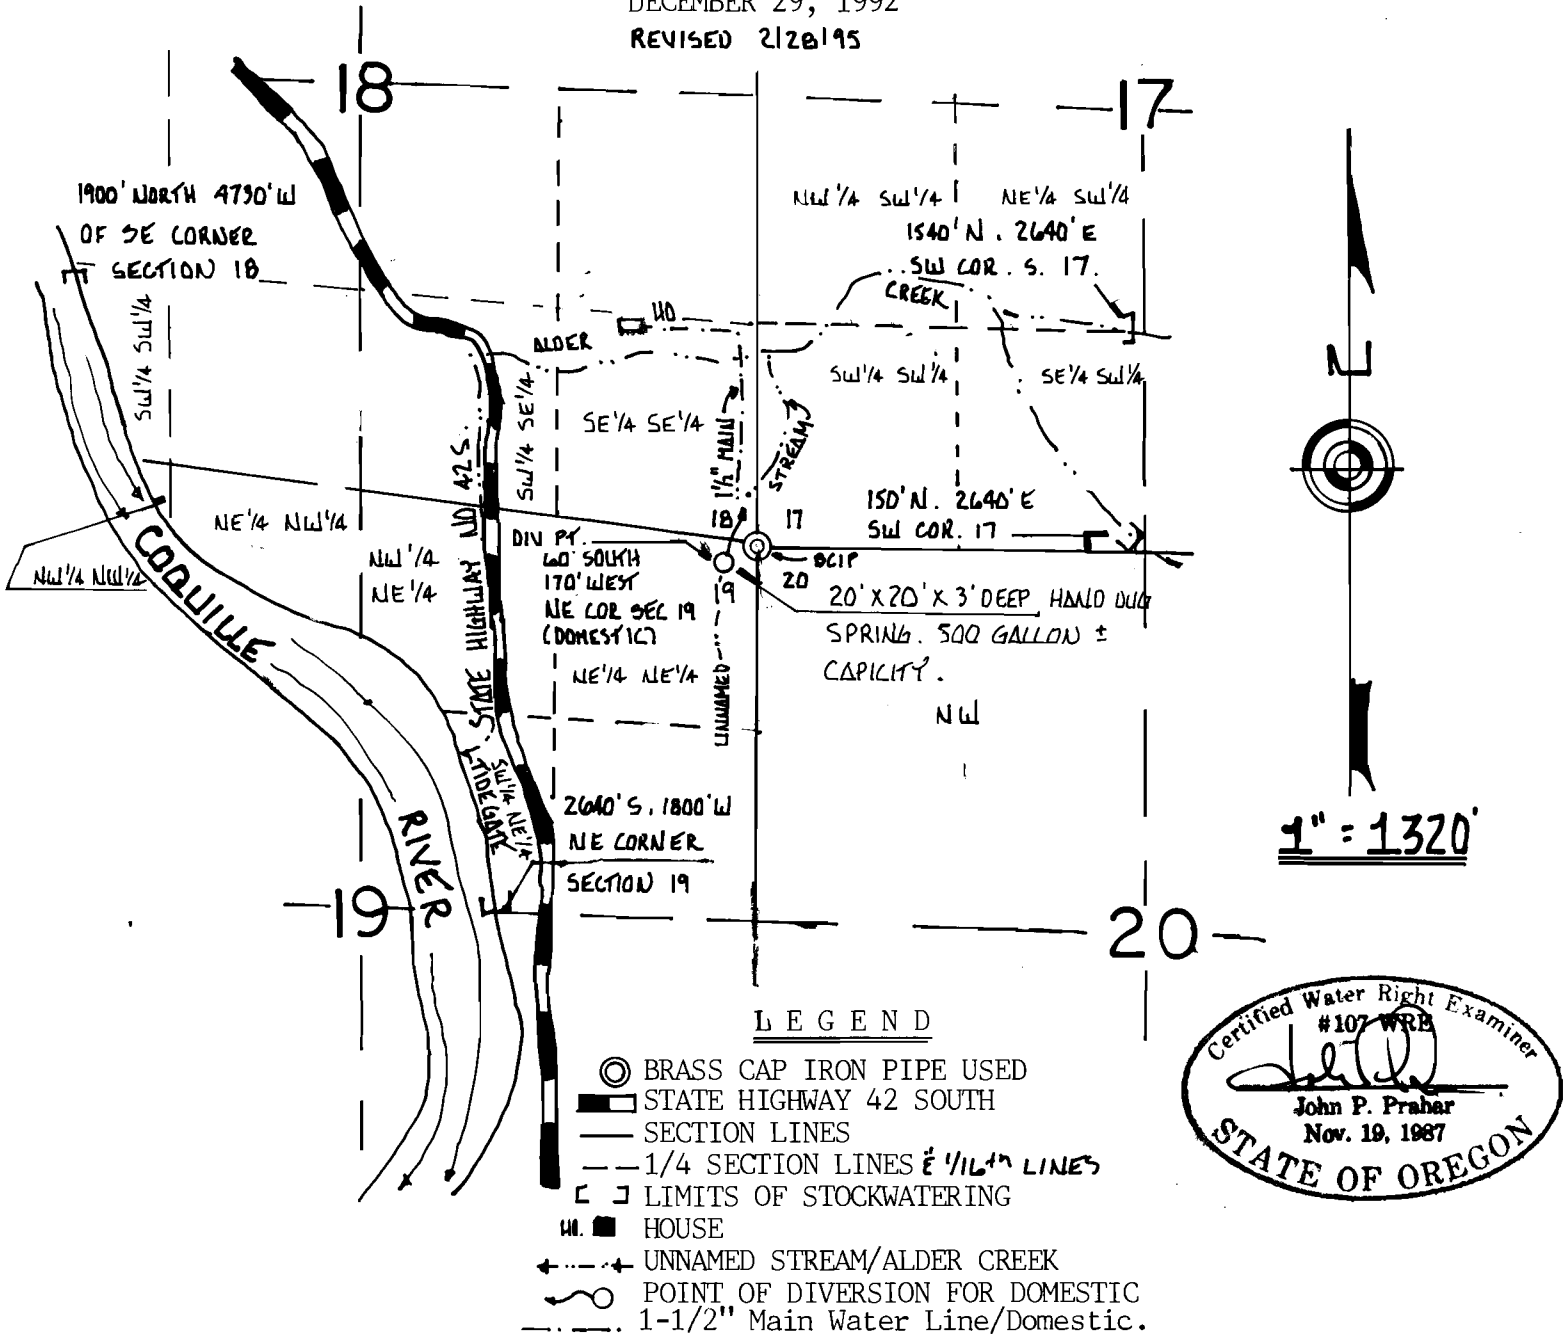

Disclaimer Statement: This map was prepared for the sole purpose of locating a water right and is not intended to give legal dimensions of show property ownership lines.

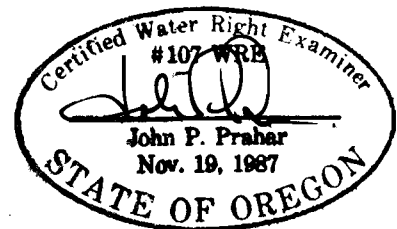

SWR-548