

RECEIVED

T. 8 S. R. 11 W. W.M.
SECTION 24
LINCOLN COUNTY, OREGON


WATER RESOURCES DEPT.
SALEM, OREGON

Domestic Use
including lawn
and garden
irrigation, not
exceeding 1/2 acre.

Perforated 4" PVC
intake in creek
bottom. 1" Pipe-
line approximately
1000 ft in length.
200 gallon storage
tank, serves
house, outbuildings
and outdoor
faucets.

livestock have
free access to
streams.


98 Head - Cattle

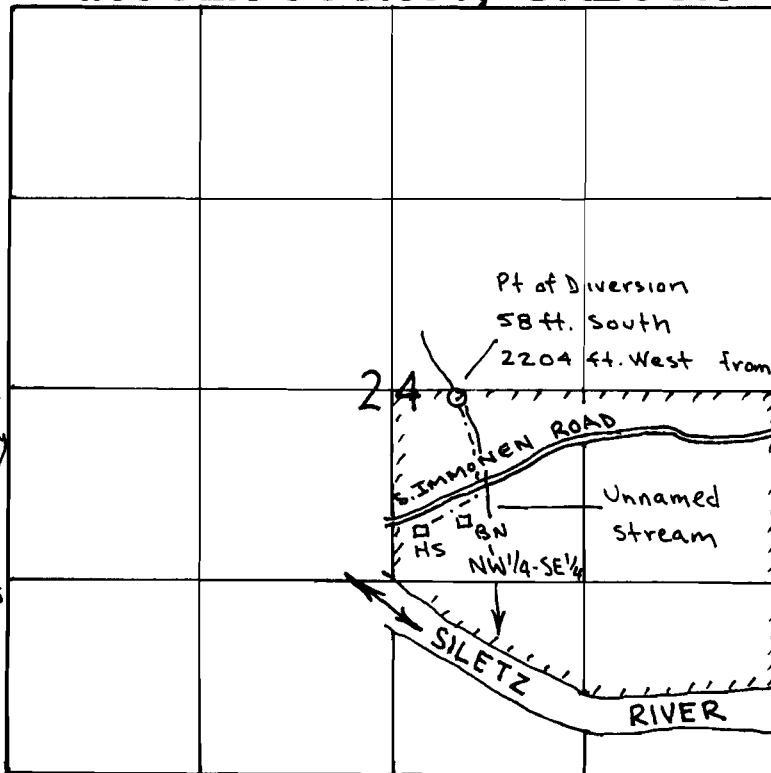

CLAIM OF BENEFICIAL USE MAP
FOR

SCALE: 1" = 1320'

SURFACE WATER REGISTRATION STATEMENT PRE-1909 VESTED WATER
RIGHT CLAIM.

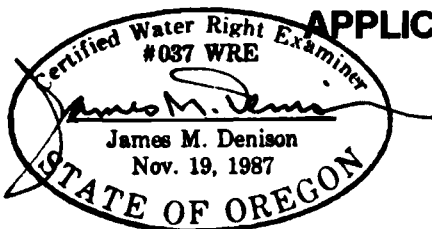

APPLICATION# SWR-550

PERMIT#

RECEIVED

IN THE NAME OF

JOE STEERE

JAN 28 1994

WATER RESOURCES DEPT.
SALEM, OREGON

SURVEYED: MAY 21, 1993

BY: J.M. DENISON

This map prepared solely for the purpose of showing location of a water right, and is not
intended for use to provide dimensions or location of property ownership lines.