

PRE-1909 VESTED WATER RIGHTS MAP SWR-551
LOCATED IN PORTIONS OF SECTIONS 11 AND 12 OF
T.31S., R.15W., W.M., CURRY COUNTY, OREGON

PREPARED FOR:
PAULINE E. SULLIVAN


PREPARED BY:
DENNIS R. GOUDE

DATE SURVEYED:
NOVEMBER 29, 1994

WATER RIGHTS

PERMIT NUMBER 1453, JAN. 20, 1915
PERMIT NUMBER 46541, SEPT. 26, 1989

- P.O.D. 1 IS 300 FEET SOUTH AND 2340 FEET WEST
OF THE NORTHEAST CORNER OF SECTION 12
T.31S., R.15W.
- P.O.D. 2 IS 1045 FEET SOUTH AND 2960 FEET WEST
OF THE NORTHEAST CORNER OF SECTION 12
T.31S., R.15W.
- P.O.D. 3 IS 1580 FEET SOUTH AND 1210 FEET WEST
OF THE NORTHEAST CORNER OF SECTION 11
T.31S., R.15W.
- P.O.D. 4 IS 920 FEET SOUTH AND 1015 FEET WEST
OF THE NORTHEAST CORNER OF SECTION 11
T.31S., R.15W.
- P.O.D. 5 IS 1180 FEET EAST OF THE NORTHWEST
CORNER OF SECTION 12 T.31S., R.15W.
- P.O.D. 6 IS 450 FEET SOUTH AND 735 FEET WEST
OF THE NORTHEAST CORNER OF SECTION 11
T.31S., R.15W.

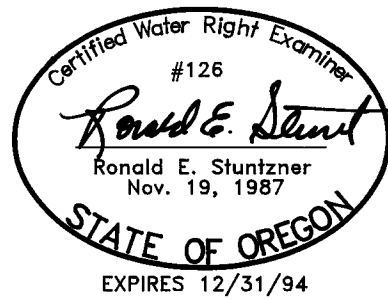


EXAMINER'S DISCLAIMER STATEMENT

THE PREPARATION OF THIS MAP WAS FOR THE PURPOSE
OF IDENTIFYING THE LOCATION OF THE WATER RIGHT ONLY
AND HAS NO INTENT TO PROVIDE DIMENSIONS OR LOCATION
OF PROPERTY OWNERSHIP LINES.

**Stuntzner Engineering
& Forestry**

ENGINEERING • LAND SURVEYING • FORESTRY
PLANNING • WATER RIGHTS

705 South 4th St.
Post Office Box 118
Coos Bay, Oregon 97420
Phone: (503) 267-2872
Fax: (503) 267-0588

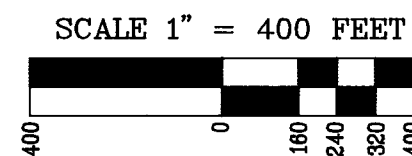

LEGEND

- RESIDENCE
- PRIVATE ROAD
- FOUND MONUMENTS
- CALC'D CORNERS
- P.O.B.
- P.O.D.
- IRRIGATED AREA
- PIPE
- IN-STREAM STOCK
WATERING

