


T 26 S; R 38 & 4 W; W.M.

REGISTRATION STATEMENT MAP


SCALE: 1" = 1320'

MAR 17 1994

WATER RESOURCES DEPT
TALENT, OREGON

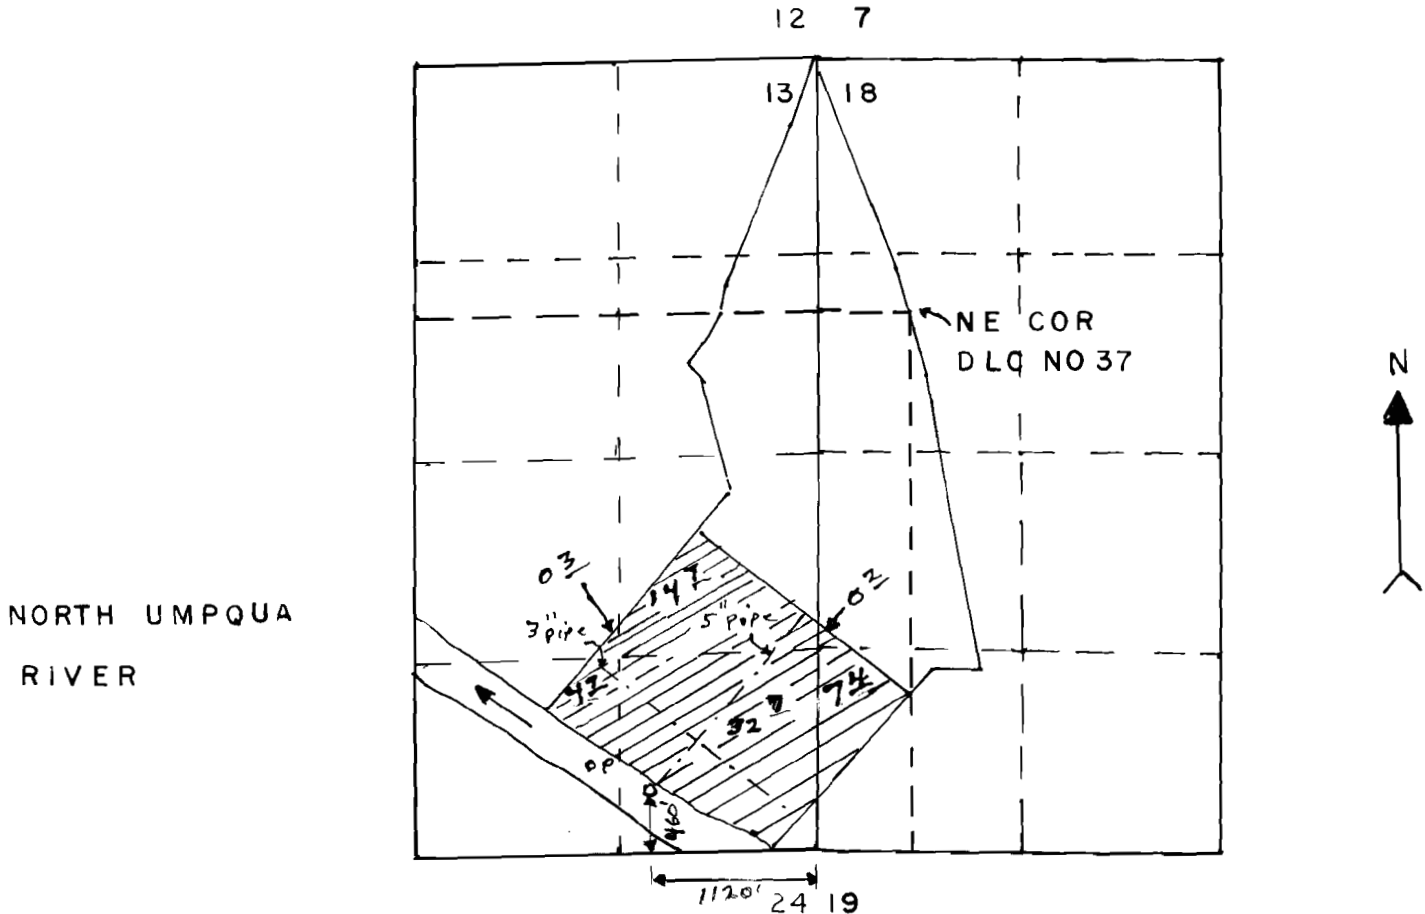

THE PURPOSE OF THIS MAP IS TO IDENTIFY THE LOCATION OF THE WATER RIGHT. IT IS NOT INTENDED TO PROVIDE INFORMATION RELATIVE TO THE LOCATION OF PROPERTY OWNERSHIP BOUNDARY LINES.

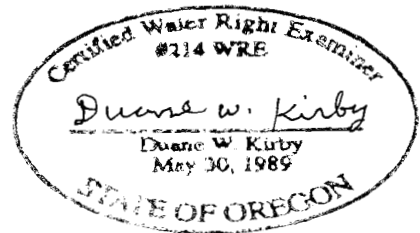

UNDER

IN NAME OF

ROBERT S MURRAY

Surveyed JAN, 9, 1994, by DUANE KIRBY

SWR-553