

T.27S., R.7 W., W.M.
SECTION 32


REGISTRATION STATEMENT MAP

SCALE: 1" = 400'


RECEIVED

APR 28 1993

WATER RESOURCES DEPT
SALEM, OREGON

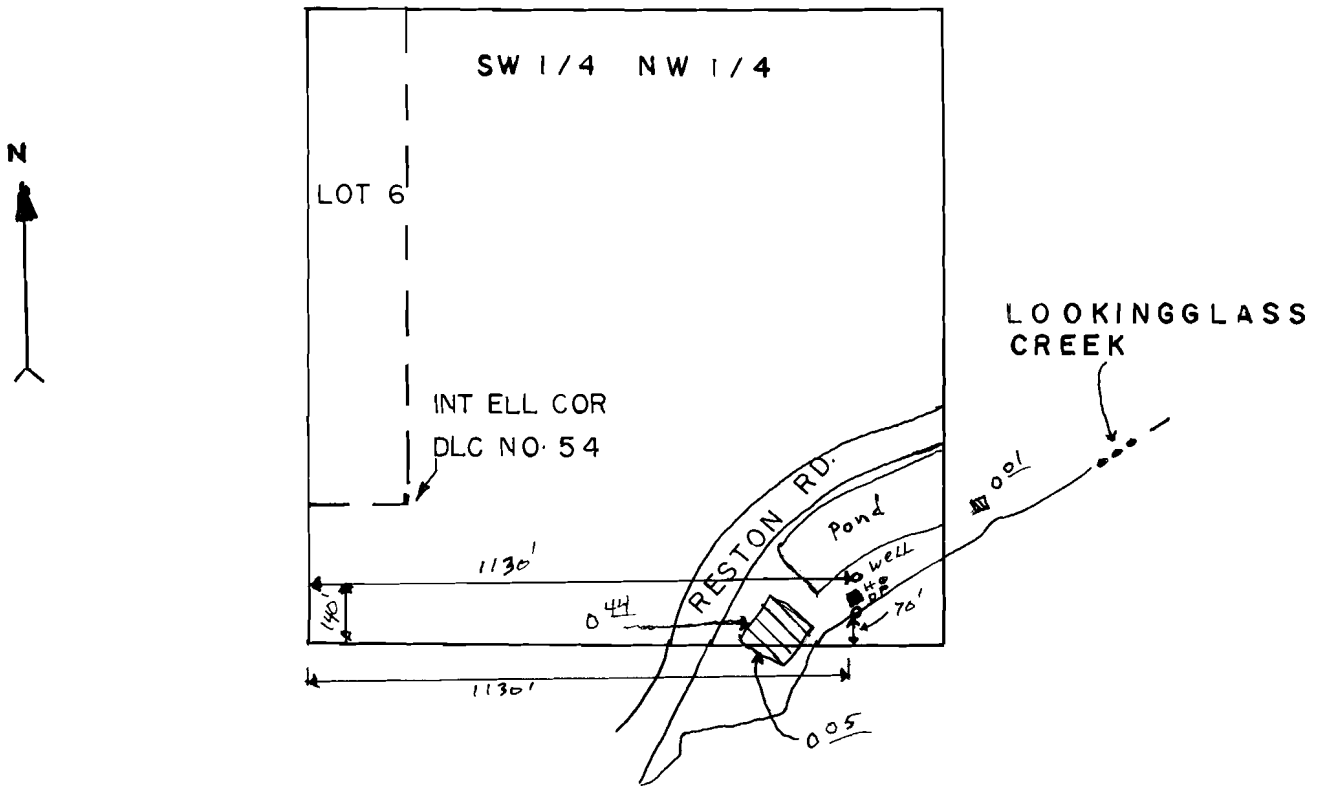

THE PURPOSE OF THIS MAP IS TO IDENTIFY THE LOCATION OF THE WATER RIGHT. IT IS NOT INTENDED TO PROVIDE INFORMATION RELATIVE TO THE LOCATION OF PROPERTY OWNERSHIP BOUNDARY LINES UNDER

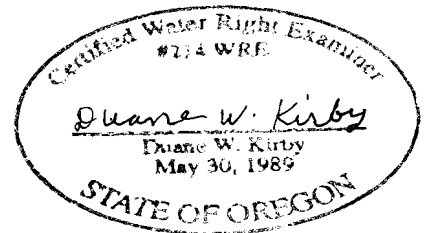

IN NAME OF
CARL W. MANSDORF
SUSAN L. MANSDORF
Surveyed FEB. 13 1993, by DUANE KIRBY