



T·28S·, R·6 W·, W·M·  
SECTION 15

SCALE: 1" = 400'

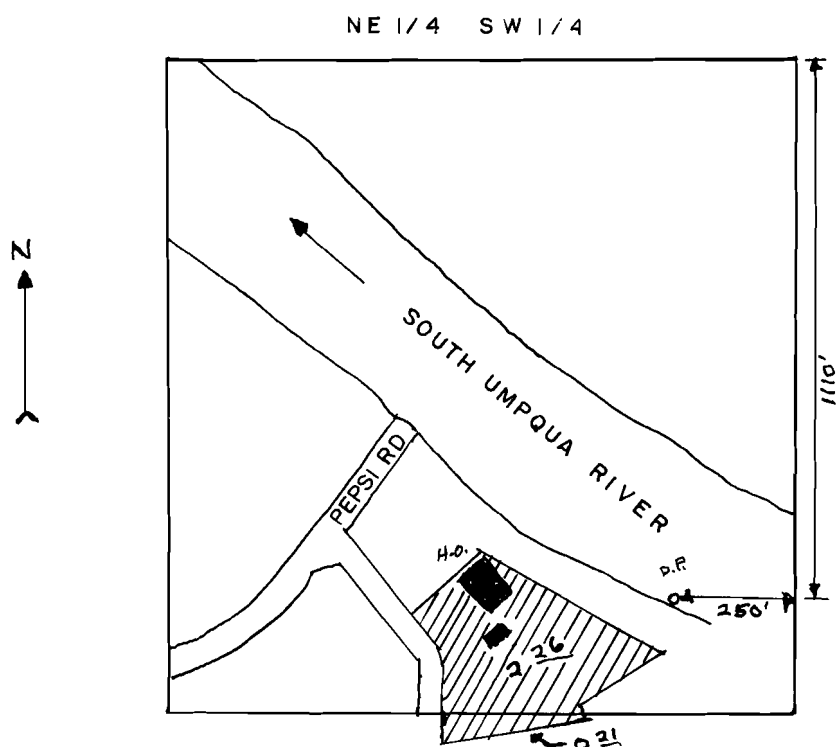

THE PURPOSE OF THIS MAP IS TO  
IDENTIFY THE LOCATION OF THE  
WATER RIGHT. IT IS NOT INTENDED  
TO PROVIDE INFORMATION RELATIVE UNDER  
TO THE LOCATION OF PROPERTY  
OWNERSHIP BOUNDARY LINES

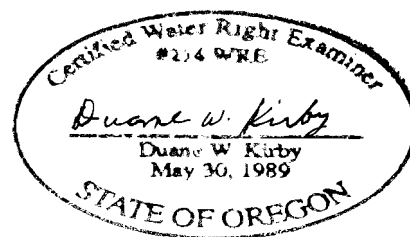

IN NAME OF

BEVERLY BROWNE

Surveyed APR·10 1993, by DUANE KIRBY