


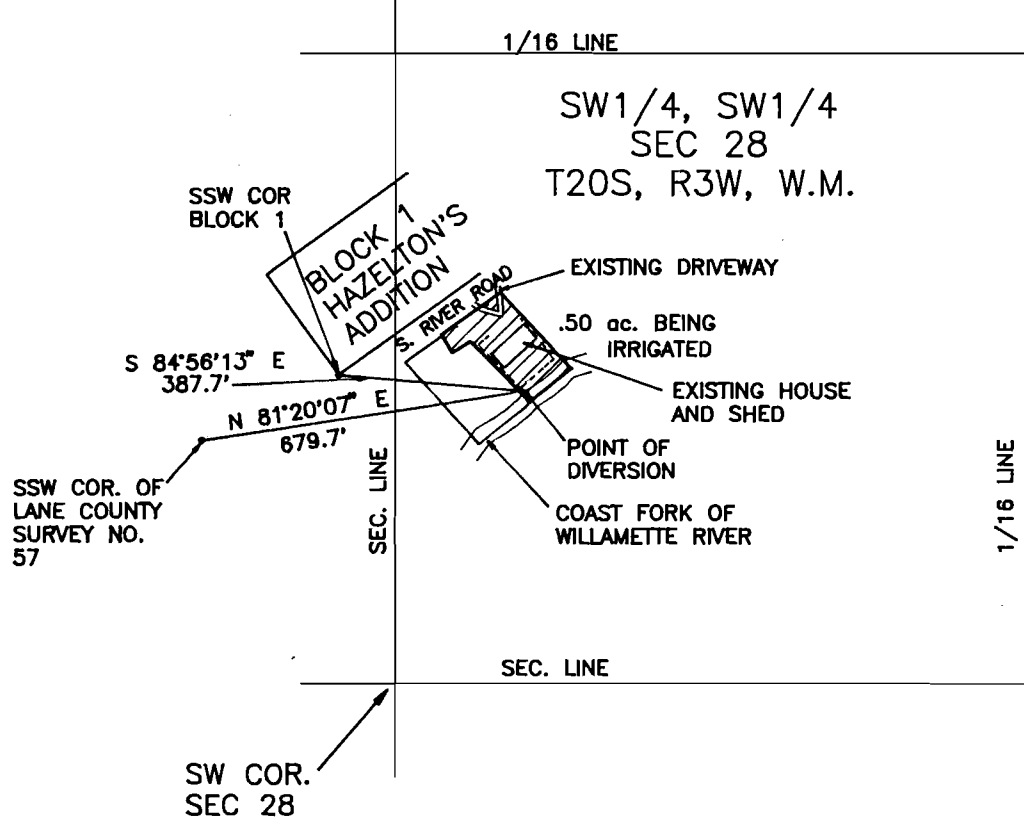

SCALE: 1"=400'
0' 200' 400' 600'




LEGEND

----- Denotes 3/4" P.V.C. Water Pipe

Ex. Pump: Jacuzzi
Model 15DL1-5B
Dayton Motor 1 1/2 h.p.
Mod. #5K4698
2" Intake, 1" Discharge
Approx. 50 GPM.

FINAL PROOF MAP

THIS MAP IS FOR THE PURPOSE OF IDENTIFYING THE WATER RIGHT ONLY AND IS NOT TO PROVIDE LEGAL DIMENSIONS OR LOCATIONS OF PROPERTY OWNERSHIP LINES.

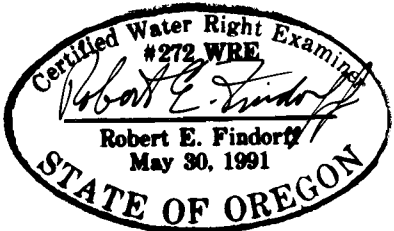

WATER RIGHTS SURVEY FOR JOE KING
SW1/4, SW1/4, SEC. 28, T20S, R3W W.M., LANE COUNTY, OR.

Geomax
OF OREGON, INC.
ENGINEERING, LAND SURVEYING, BUILDING DESIGN
608 N. NORTH STREET COTTAGE GROVE, OREGON 97424
TELEPHONE - (503) 842-0128 FAX - (503) 842-7035

JOB NO.: 9304	DRAWN: T.F.V.	CHECKED: R.E.F.
DATE: 2/3/93	SHT. 1	OF 1

SWR-605