



T. 27 S., R. 13 W. Sec. 20, 29 & 32

Map for a pre-1909 Surface Water Registration

This map is not the result of a property
Survey and is not to be used as such.

For: Charlie H. Waterman



Note: All coordinates shown on this map were
measured from A. Photo No. O-86-ACBC 2-130-5

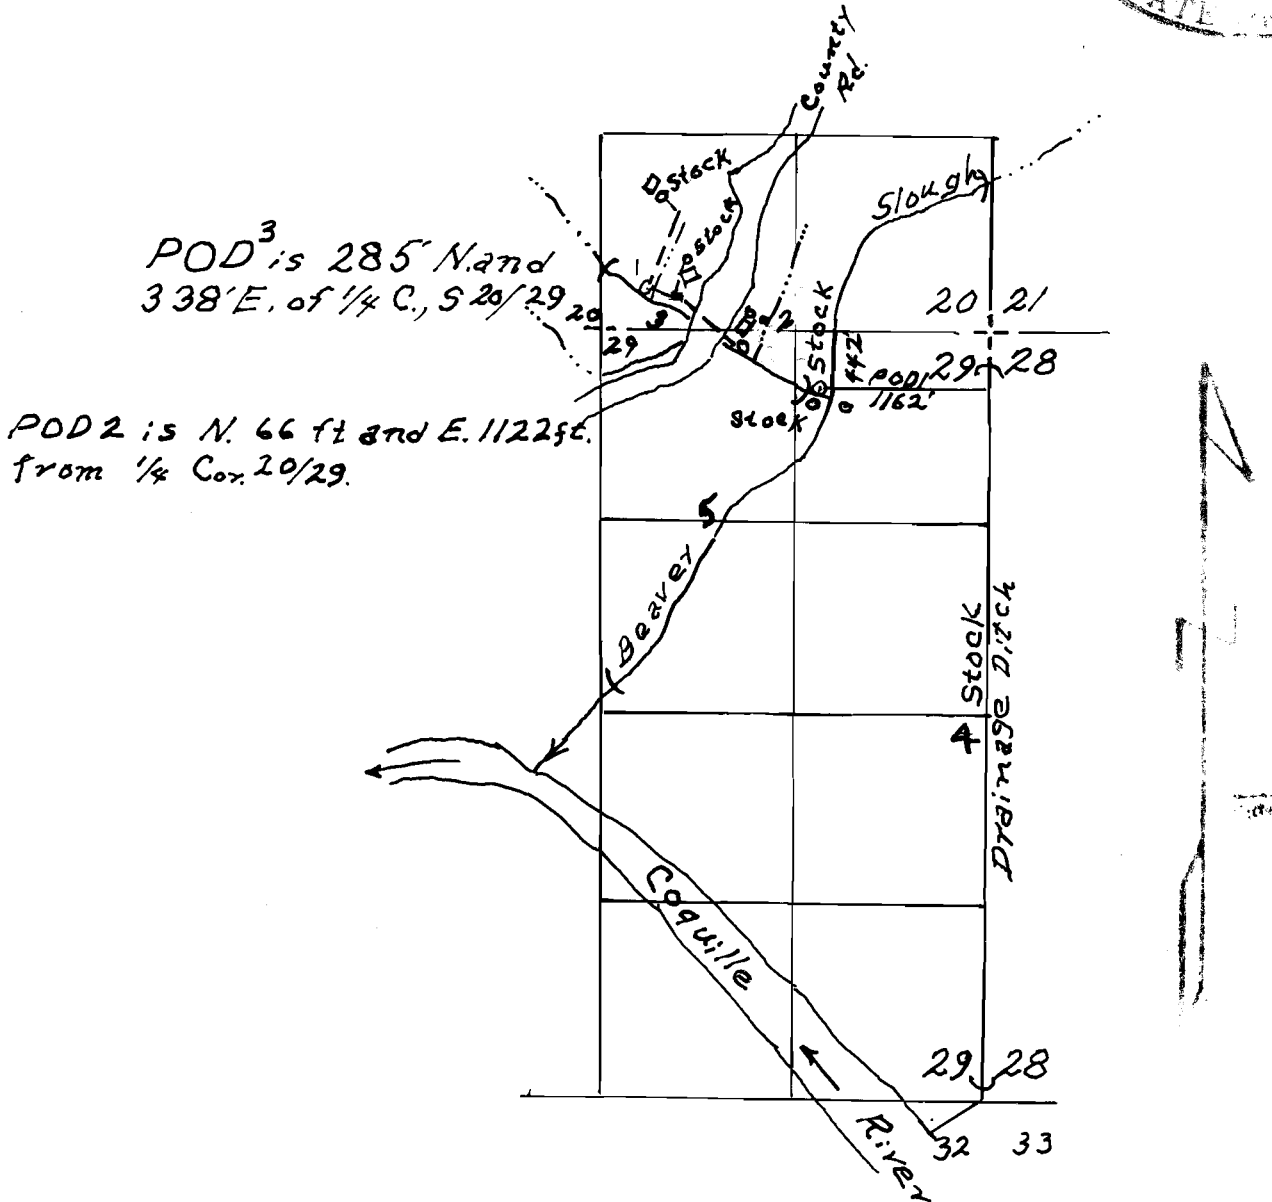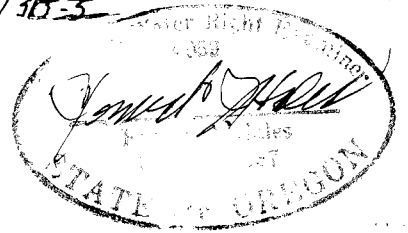

T. 27 S., R. 13 W. Sec. 20, 29 + 32

Overlay Showing Original Homestead Ownerships.

Charlie H. Waterman.

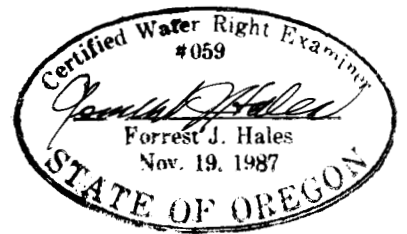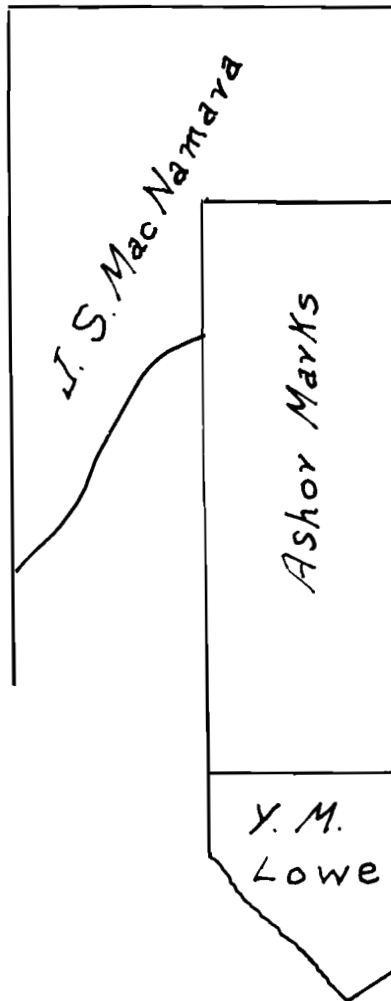

RECEIVED

NOV 20 1987

WATER RESOURCES DIVISION
SALEM OREGON