


GENERAL MAP


**Boise Cascade Vener Plant
Point of Diversion and Place of Use**

note: ~~_____ map is being prepared.~~

Application by: Boise Cascade Corporation
 P.O. Box 338
 St. Helens, Ore. 97051

Prepared by: Mark Madison/CH2M Hill/CWRE
 Date: Dec 92

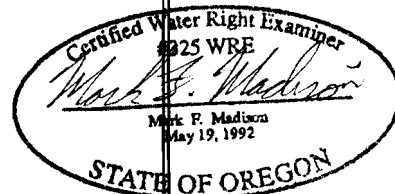

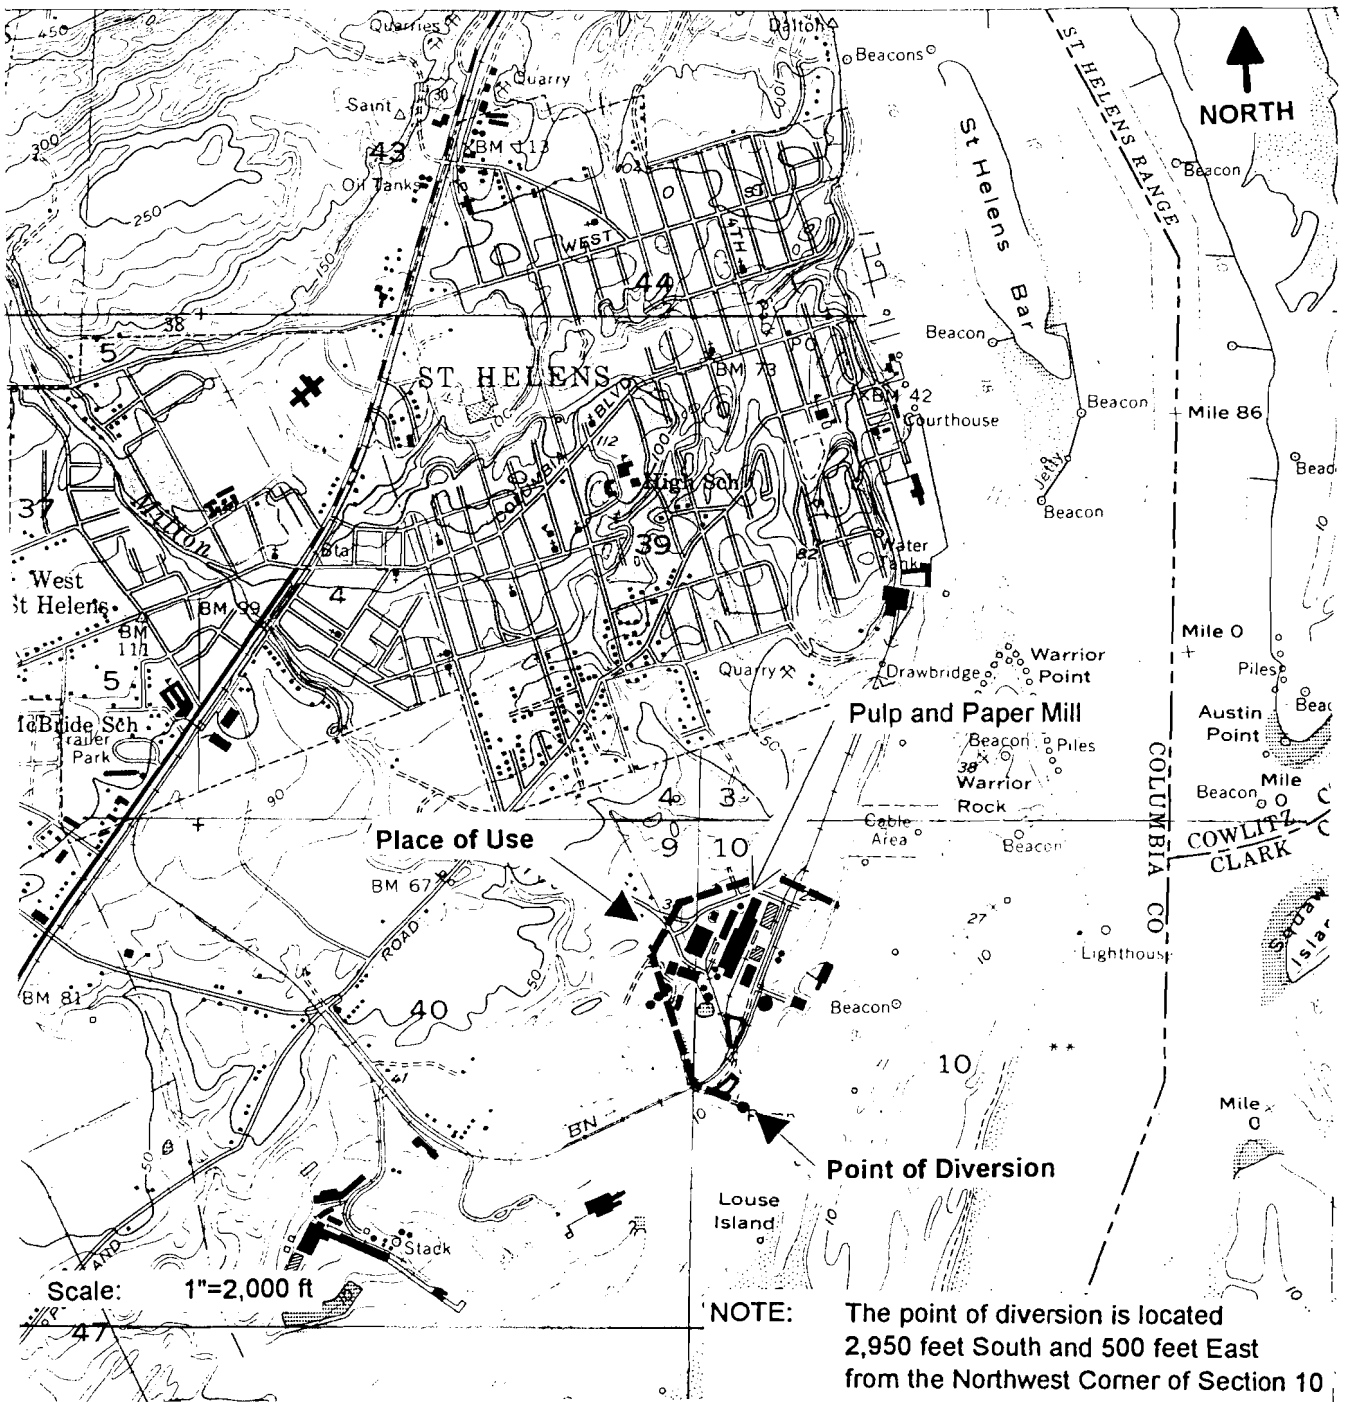

GENERAL MAP

**Boise Cascade Pulp and Paper Mill
Point of Diversion and Place of Use**

note: **[Redacted]** survey map is being prepared.

Application by: Boise Cascade Corporation
 1300 Kaster Rd.
 St. Helens, Ore. 97051

Prepared by: Mark Madison/CH2M Hill/CWRE

Date: Dec-93

