


Section 33 Township 20S Range 10W W.M.  
Douglas County

Scale 1" = 1320'

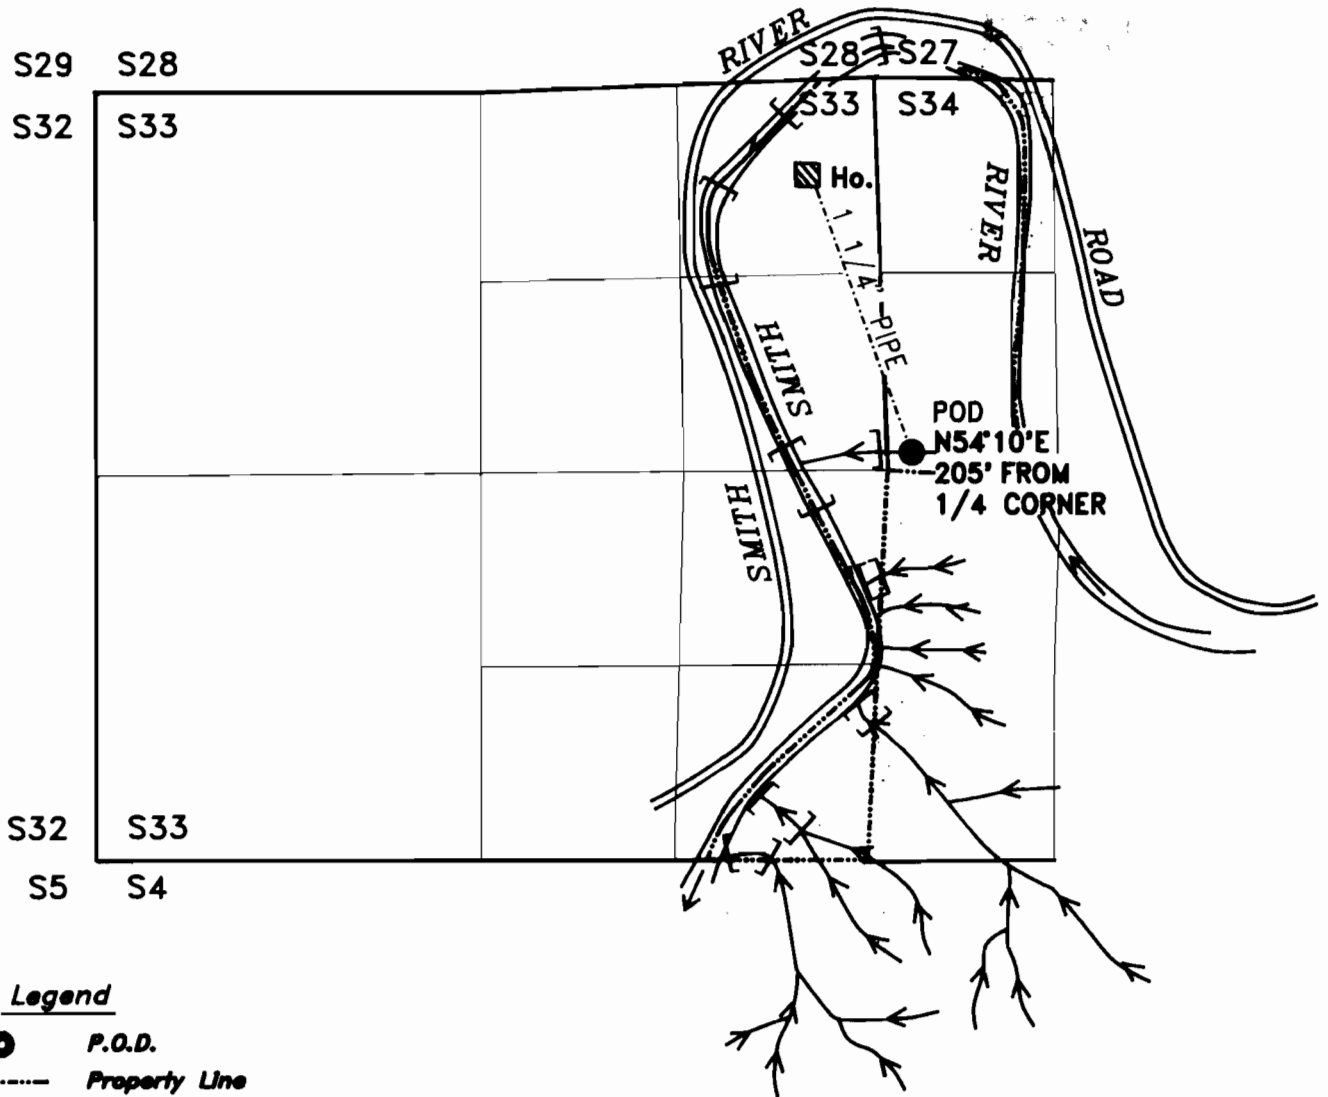


Legend

- P.O.D.
- Property Line
- Creek
- Waterline
- ▨ Home Including 1/2 acre irrigation lawn & garden
- [ ] Stock Watering

EXAMINERS DISCLAIMER STATEMENT

The preparation of this map was for the purpose of identifying the location of the Water Right only and has no intent to provide dimensions or location of property ownership lines.

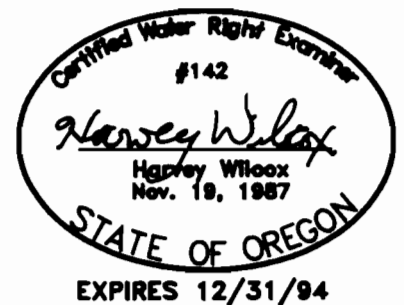

**PRE 1909 VESTED WATER RIGHTS SURVEY**

IN THE NAME OF

Eugene Haggerty

Surveyed on December 20, 1992 by H.A. Wilcox