


T.25 S., R.12 W.W.M.

SECTION 29

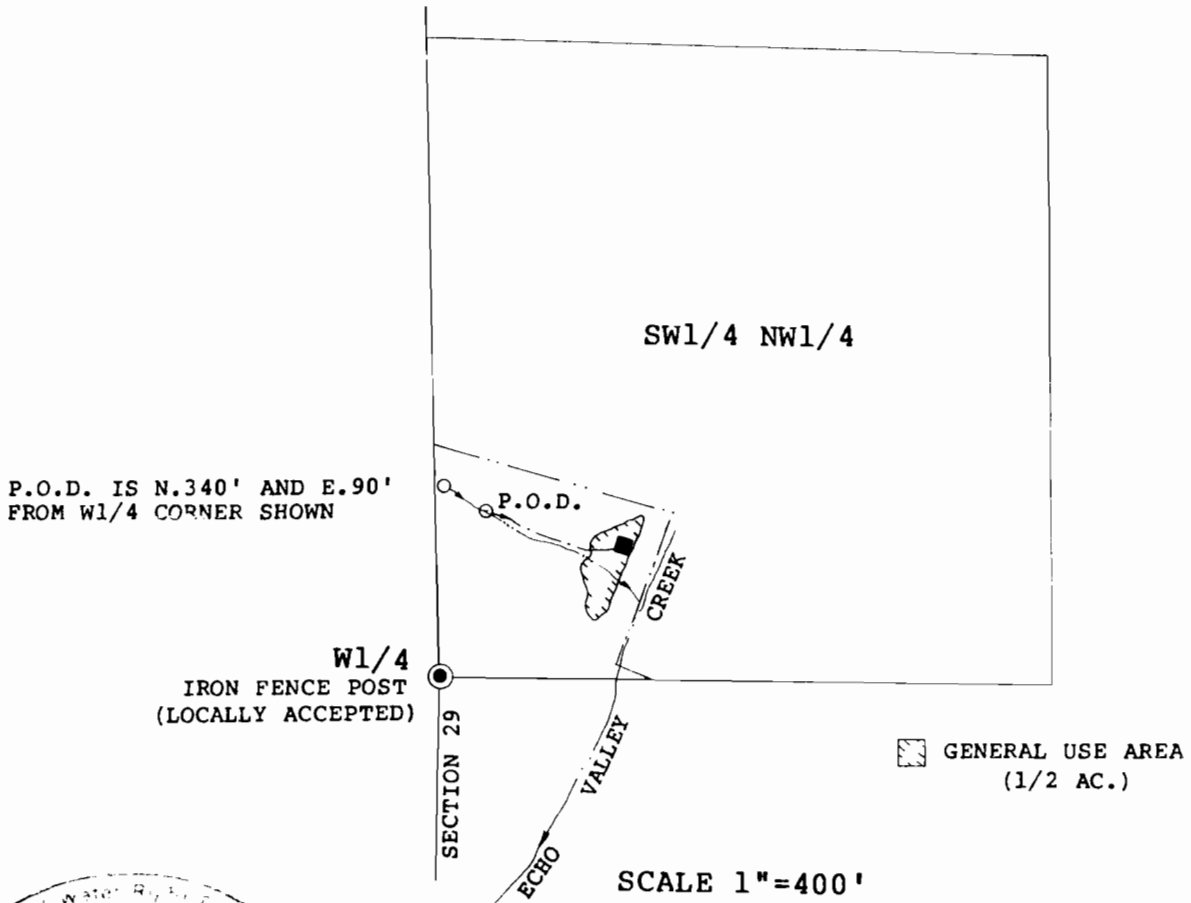

FINAL PROOF SURVEY

UNDER

APPLICATION NO.70127 PERMIT NO.50848

IN THE NAME OF

A.JO AN CONWAY

SURVEYED SEPT.24,1992 BY CWRE RONALD E.STUNTZNER