



T.285., R.14W., W.M

SURVEY TO CLAIM TO PRE-1909 VESTED WATER RIGHT

SURVEYED ON MARCH 23, 1992

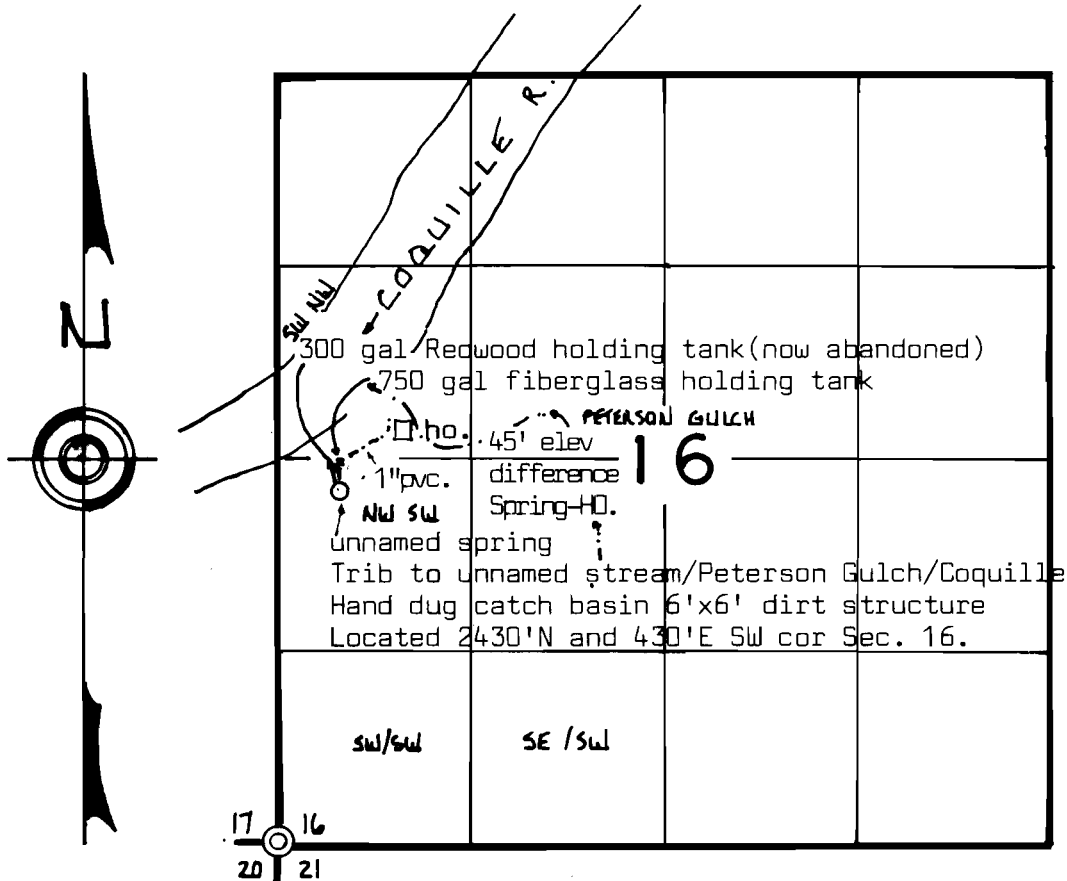

SCALE: 4" = 1 Mile

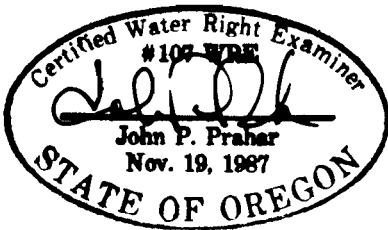

PREPARED FOR: JOHN PARKS
RT. 2 BOX 1115
BANDON, OR 97411

PREPARED BY: PRAHAR SURVEYING
1045 BALTIMORE #1
BANDON, OR 97411

DISCLAIMER: THIS MAP WAS PREPARED FOR THE SOLE PURPOSE OF
LOCATING A WATER RIGHT AND IS IN NO WAY INTENDED
TO SHOW PROPERTY OR OWNERSHIP LINES

[Signature] CWRE #107