


PRE -1909 VESTED WATER RIGHT CLAIM MAP
IN THE NAME OF WALLACE R. STINSON

SECTION 10, T 28S, R 10W, W.M.

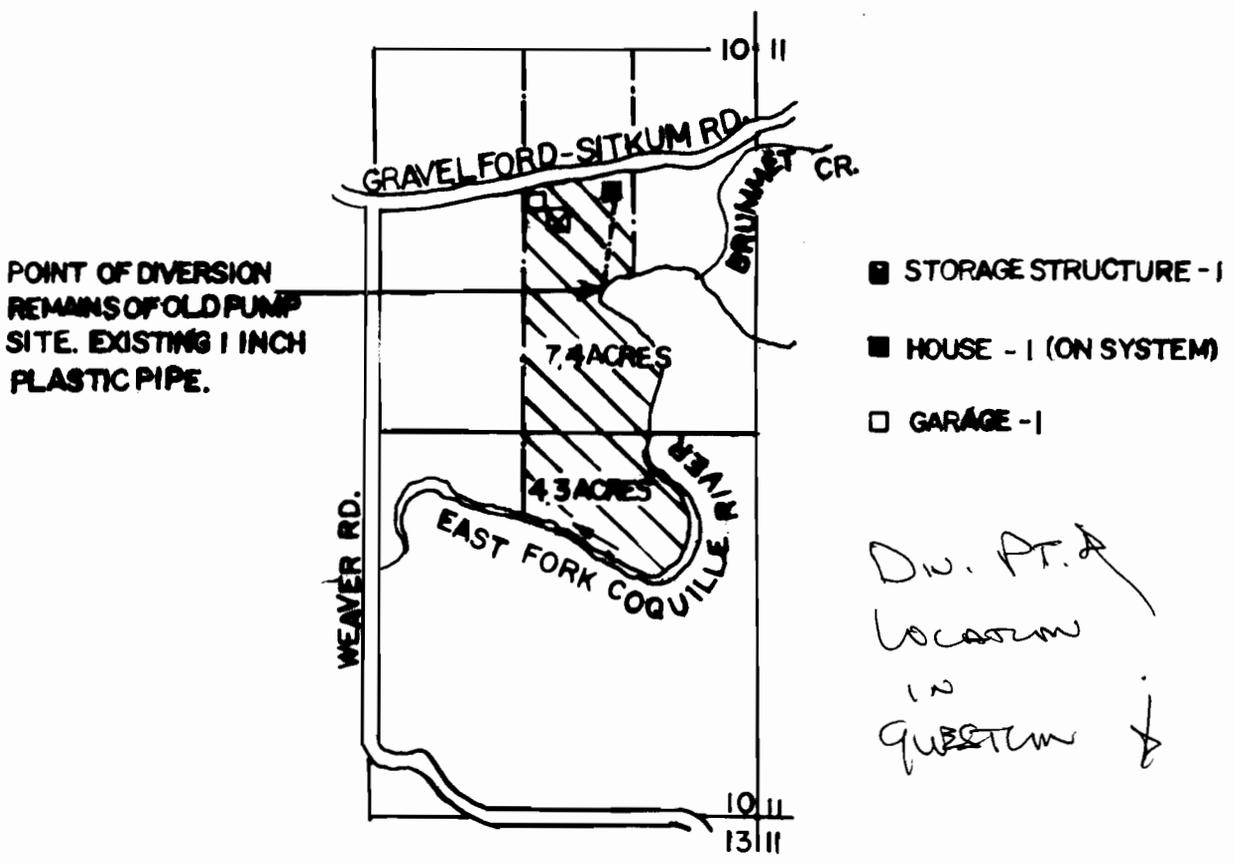

1 INCH = 660 FEET



MAP PREPARED BY: Michael J. Stinson

DATE OF SURVEY: MAY 17, 1992

THE POINT OF DIVERSION IS LOCATED 538 FEET WEST AND 830 FEET SOUTH FROM THE EAST 1/4 CORNER OF SECTION 10 WITHIN THE NE 1/4 OF THE SE 1/4 OF SECTION 10 TOWNSHIP 28 SOUTH, RANGE 10 WEST, W.M., COOS COUNTY.

THE PURPOSE OF THIS MAP IS IDENTIFY THE LOCATION OF THE WATER RIGHT, IT IS NOT INTENDED TO PROVIDE INFORMATION RELATIVE TO THE LOCATION OF PROPERTY OWNERSHIP BOUNDARY LINES.