

**SWR-92**



Scale: 1" = 400 ft.

**POINTS OF DIVERSION**


1. 2,050 ft. North & 670 ft. West of the SE corner of Section 28.
2. 570 ft. North & 1,310 ft. West of the SE corner of Section 28.
3. 240 ft. South & 2,190 ft. West of the NE corner of Section 33.

**WATER USE REGISTRATION MAP FOR ADJUDICATION IN THE SE 1/4 OF SECTION 28 AND IN THE NW 1/4 NE 1/4 OF SECTION 33, T 29 S, R 3 W, W. M., DOUGLAS COUNTY, OREGON**

Application No. \_\_\_\_\_  
 Permit No. \_\_\_\_\_

For: Dock A. & Lavina H. Perkins  
 6465 Days Creek Road  
 Days Creek, Oregon 97429

By: Shaner Engineering, Inc.  
 P. O. Box 1430  
 Roseburg, Oregon 97470

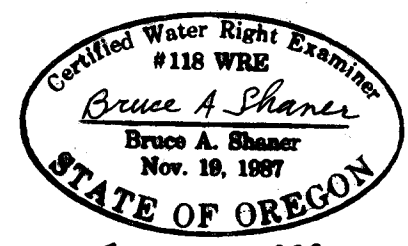

Sept. 24, 1992