


T·28S·, R·6 W·, W·M·

SCALE: 4" = 1 MILE

REGISTRATION STATEMENT MAP

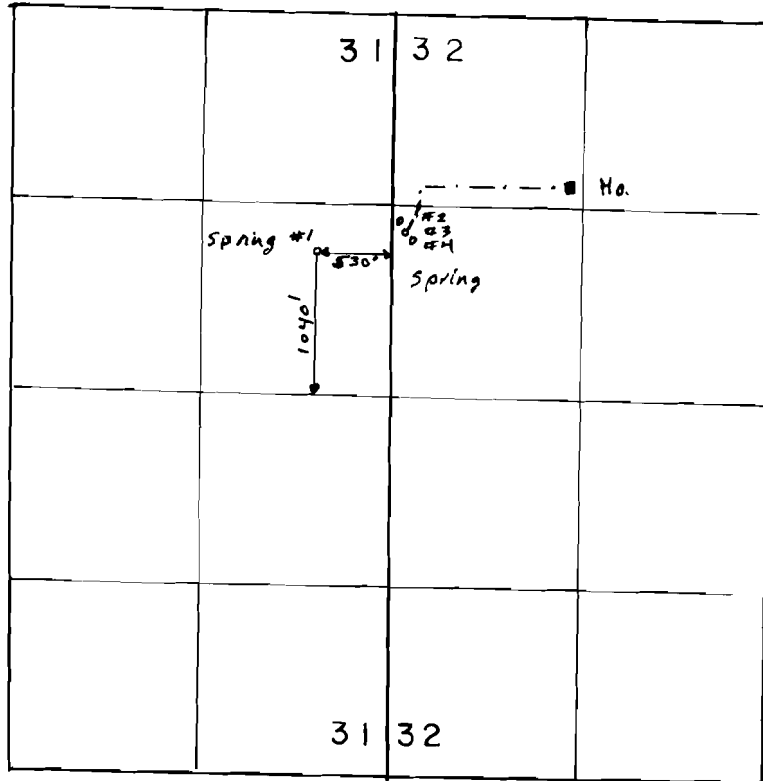

THE PURPOSE OF THIS MAP IS TO IDENTIFY THE LOCATION OF THE WATER RIGHT. IT IS NOT INTENDED TO PROVIDE INFORMATION RELATIVE TO THE LOCATION OF PROPERTY OWNERSHIP BOUNDARY LINES.

- spring # 2 1200' N & 5' E From W/4 cor. sec 32
- spring # 3 1170' N & 40' E From W/4 cor. sec 32
- spring # 4 1120' N & 80' E From W/4 cor sec 32

UNDER

IN NAME OF

CHARLES MCCORD

Surveyed Sept. 12, 1992, by DUANE KIRBY.

