


Township 2. S.

Range 45. E.W.M.

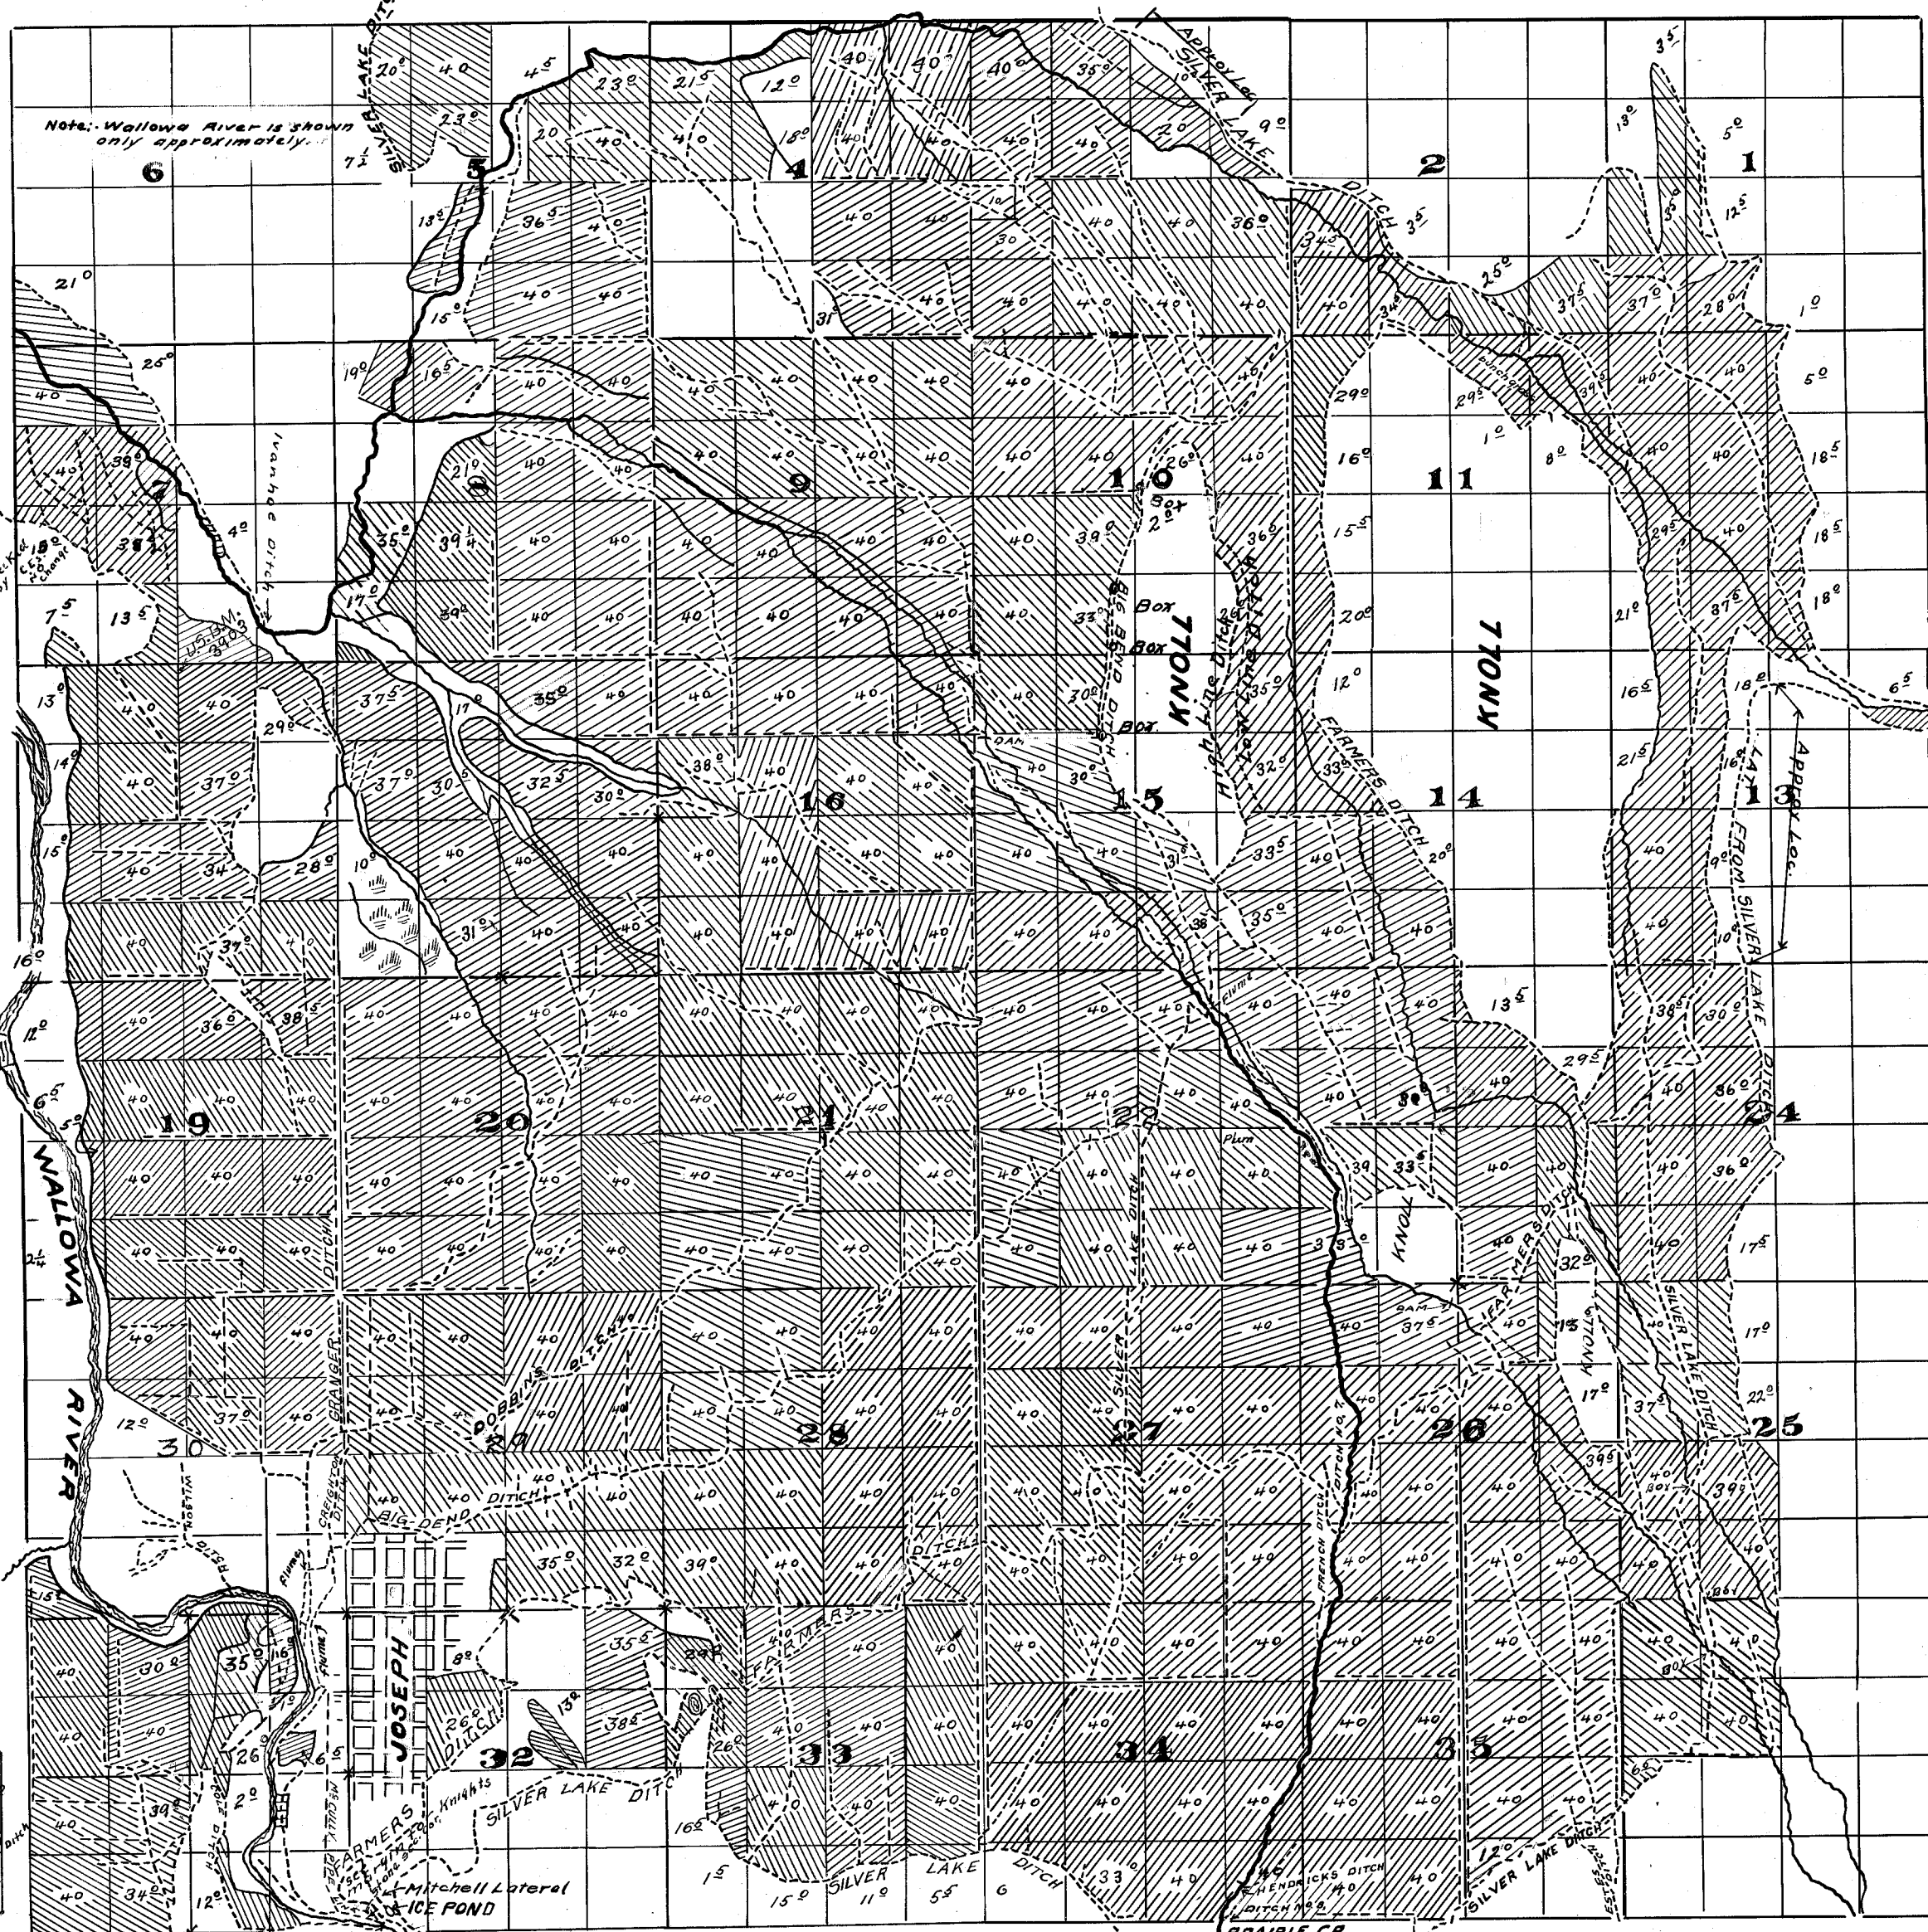


Note: Wallowa River is shown only approximately.

Point of div. of Granger Ditch
 Point of div. of Big Bend Ditch
 Point of diversion of the Dawson-Creighton Ditch
 These ditches also pick up water from the Joseph Light & Power plant and Joseph Milling Co. after passing through the turbines.



Scale 1" = 600'

Sec 30 Sec 29
" 31 " 32

Showing NW Knight land scale 2 1/2 mi. 1 cor.

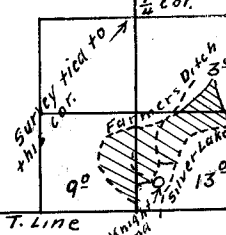

NW-SW, SEC. 23, T 2 S R 45 E.


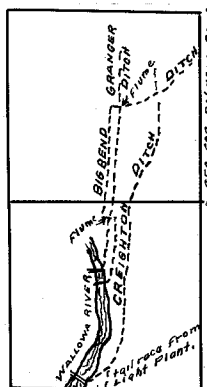
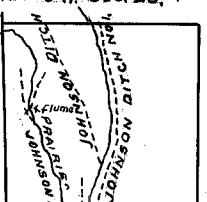


- Irrigated land with areas.
- Ditches
- Streams
- Located corners.

Survey Sept. 1914.

Adjudication Survey
Wallowa River
and
Tributaries.

Township 2 S., Range 44 E.W.M.

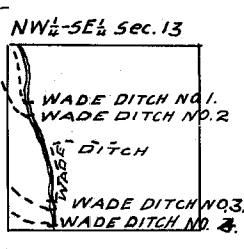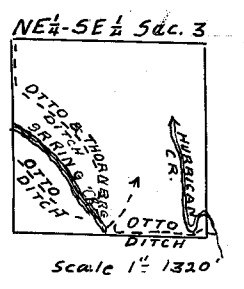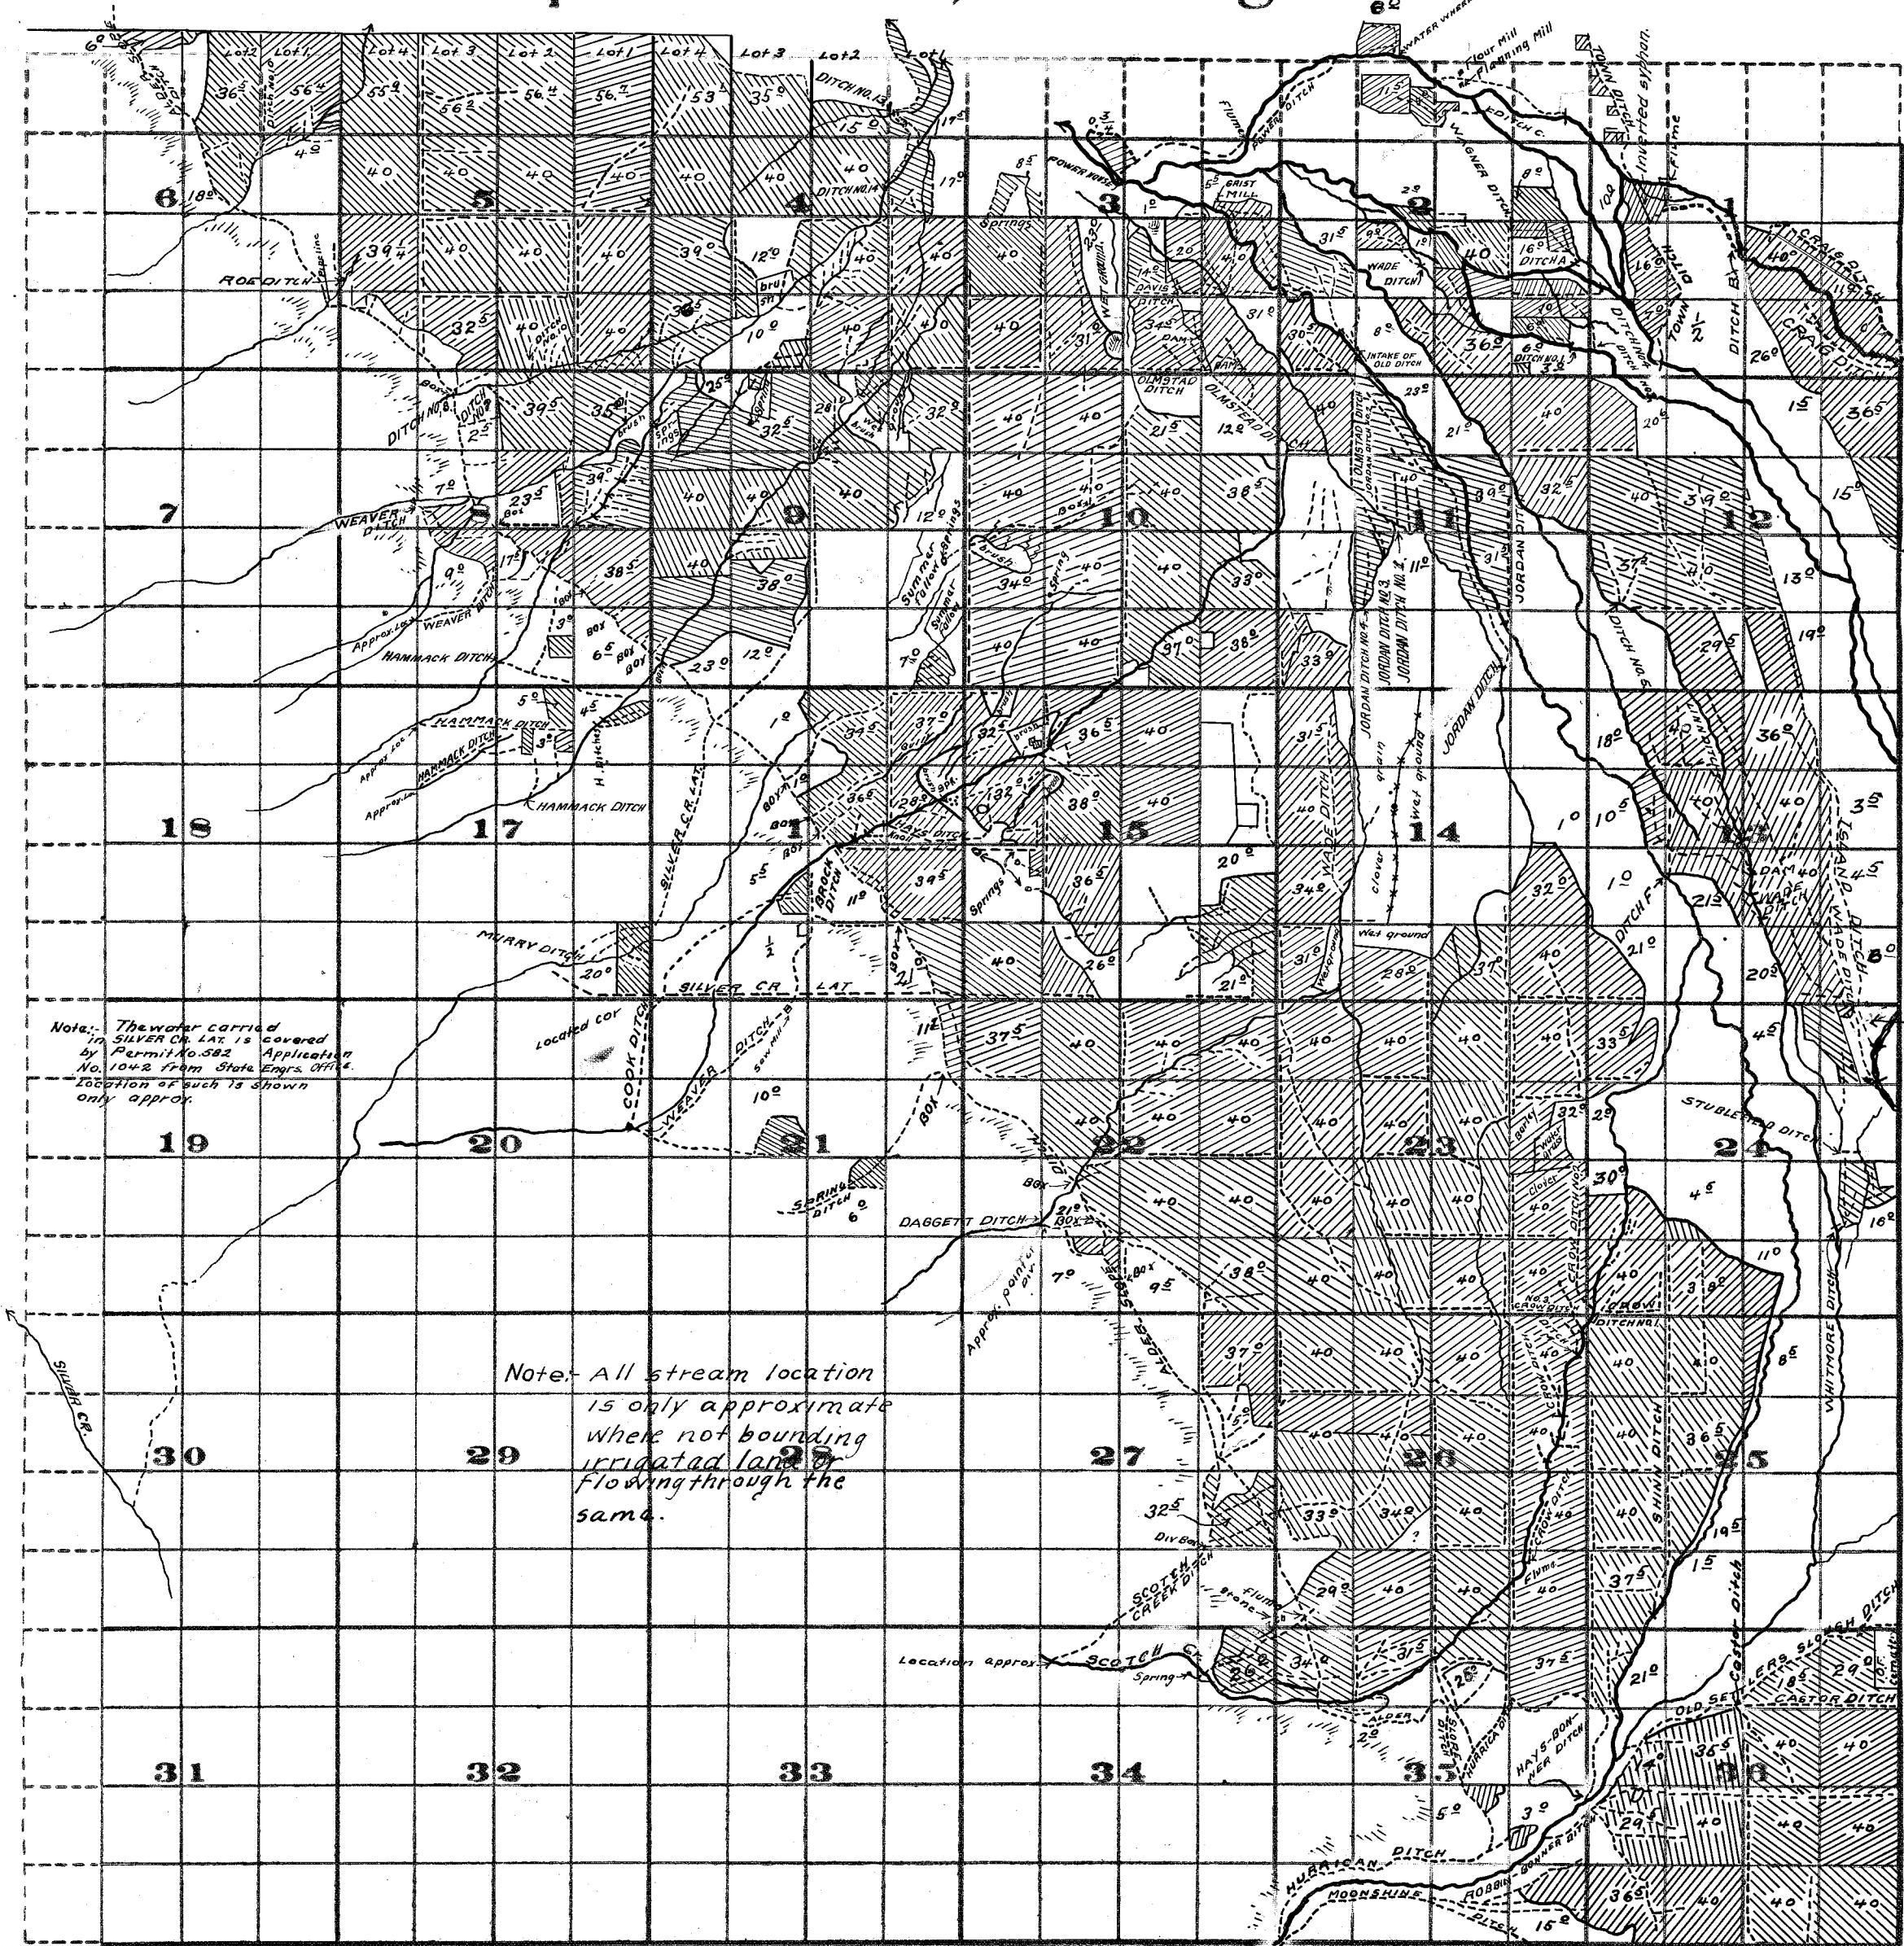

- LEGEND -
 Irrigated land with areas.
 Ditches.
 Streams.
 Located corners.

Survey Sept. 1914.

Adjudication Survey
 Wallowa River
 and
 Tributaries.