
STATE OF OREGON EXEMPT USE WELL MAP

(as required by ORS 537.545 & OAR 690.190)
This map is supplemental to the WATER SUPPLY WELL REPORT

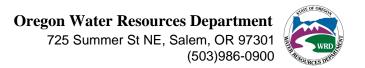

LOCATION OF WELL

Latitude: 45.538320 Longitude: -119.924279 Datum: WGS84

Township/Range/Section/Quarter-Quarter Section: 1N 23E 27 NWSE

Address of Well: 66066 HWY 74 IONE, OR

Well Label #: L100123 Well Log: MORR 51857 Printed: Feb 28, 2011

DISCLAIMER: This map is intended to represent the approximate location of the exempt use well provided by the land owner. It is not intended to be construed as survey accurate in any manner.

