


EXEMPT USE WELL LOCATION MAP

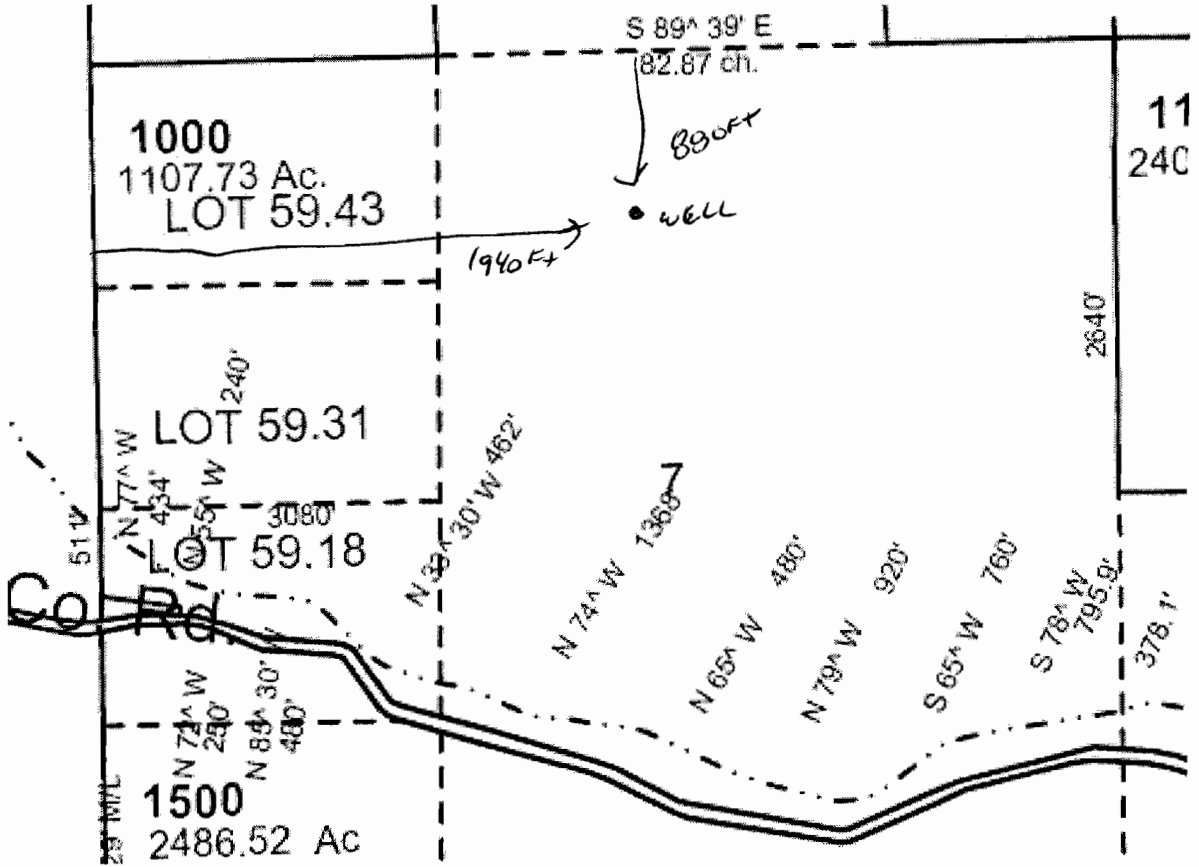

**Umatilla County**

Assessor Map Reference Number: 1N 31E 7 NENW; Tax Lot; 1000.

Street Address of Well, if Available: 69167 Owen Lane, Pilot Rock, OR.

Well Log #: **UMAT 56676**. Well Label (ID Tag) # **L 100149**. (Please Locate Well and Indicate distance From Property or Survey Corner, See Attached Sample Well Location Map.) **You may also locate your well using our exempt use well mapping tool on our website at [www.wrd.state.or.us/OWRD/exempt\\_use\\_788\\_info.shtml](http://www.wrd.state.or.us/OWRD/exempt_use_788_info.shtml) or by contacting the Exempt Use Well Program Coordinator at 503 986-0861.**

MAP NOT TO SCALE

**RECEIVED**

OCT 01 2010

WATER RESOURCES DEPT  
SALEM, OREGON  
LAND OWNER SUBMITTED MAP