


EXEMPT USE WELL LOCATION MAP

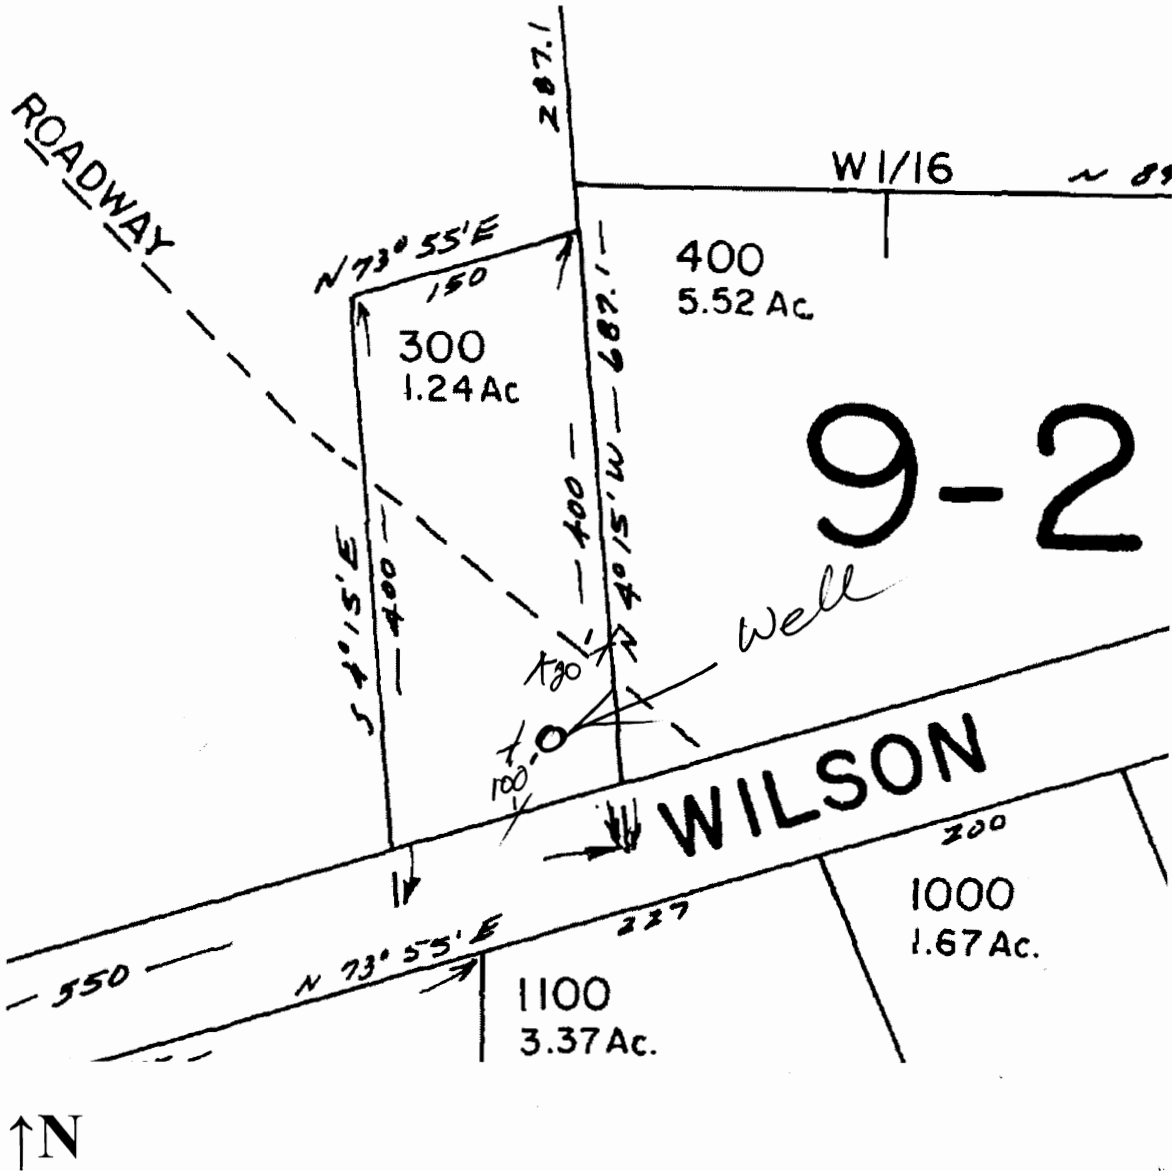

Tillamook County

Assessor Map Reference Number: 1N 7W 10 NWNW; Tax Lot 300

Street Address of Well, if Available: 48400 Wilson River Highway, Tillamook, OR

Well Log # ~~WASH~~ 68482, Well Label (ID) # L 100336. (Please Locate Well and Indicate distance From Property or Survey Corner, See Attached Sample Well Location Map.) MAP NOT TO SCALE

RECEIVED

JAN 26 2010

WATER RESOURCES DEPT
SALEM, OREGON

LAND OWNER SUBMITTED MAP