
## STATE OF OREGON EXEMPT USE WELL MAP

(as required by ORS 537.545 & OAR 690.190)
This map is supplemental to the WATER SUPPLY WELL REPORT

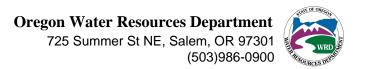

**LOCATION OF WELL** 

Latitude: 42.11821 Longitude: -121.71939 Datum: WGS84

Township/Range/Section/Quarter-Quarter Section: 40S 9E 2 NESE

Address of Well: 12080 HOMEDALE ROAD, KLAMATH FALLS, OR 97603

Well Label #: L100395 Well Log: KLAM 57412 Printed: Jun 17, 2010

DISCLAIMER: This map is intended to represent the approximate location of the exempt use well provided by the land owner. It is not intended to be construed as survey accurate in any manner.

