


EXEMPT USE WELL LOCATION MAP

SEE MAP :

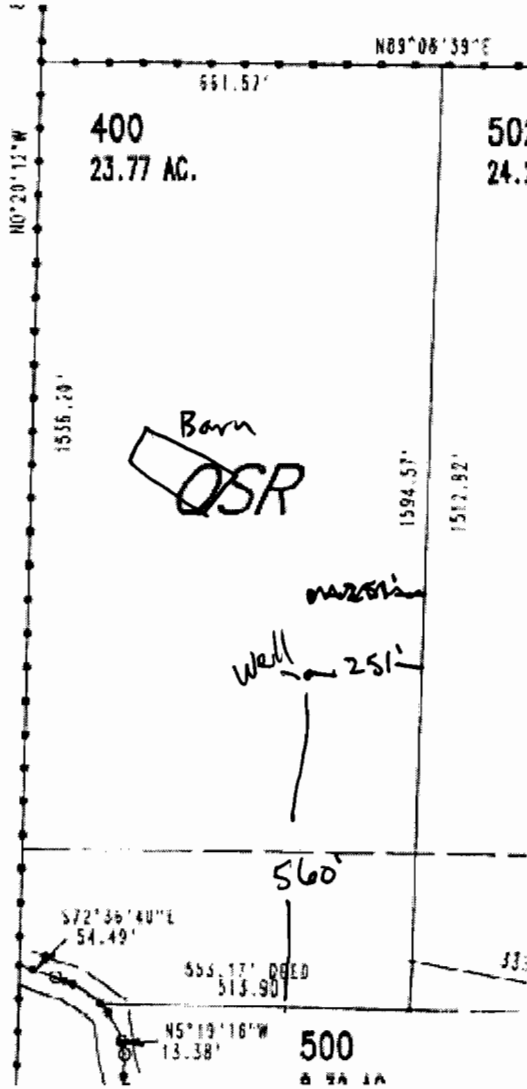

RECEIVED

FEB 10 2010

WATER RESOURCES DEPT
SALEM, OREGON



Jackson County

Assessor Map Reference Number: 39S 2W 8 NENE; Tax Lot 400

Street Address of Well, if Available: 9090 Sterling Creek Road, Jacksonville, OR

Well Log # JACK 59411, Well Label (ID Tag) # L 100469. (Please Locate Well and

Indicate distance From Property or Survey Corner, See Attached Sample Well Location

Map.) MAP NOT TO SCALE