
STATE OF OREGON EXEMPT USE WELL MAP

(as required by ORS 537.545 & OAR 690.190)
This map is supplemental to the WATER SUPPLY WELL REPORT

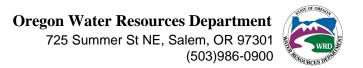

LOCATION OF WELL

Latitude: 42.285481 Longitude: -122.576910 Datum: WGS84

Township/Range/Section/Quarter-Quarter Section: 38S 2E 10 NWNW

Address of Well: 658 SHALE CITY RD Ashland OR 97520

Well Label #: L101070 Well Log: JACK 60733 Printed: Aug 22, 2011

DISCLAIMER: This map is intended to represent the approximate location of the exempt use well provided by the land owner. It is not intended to be construed as survey accurate in any manner.

