


BENT 53972

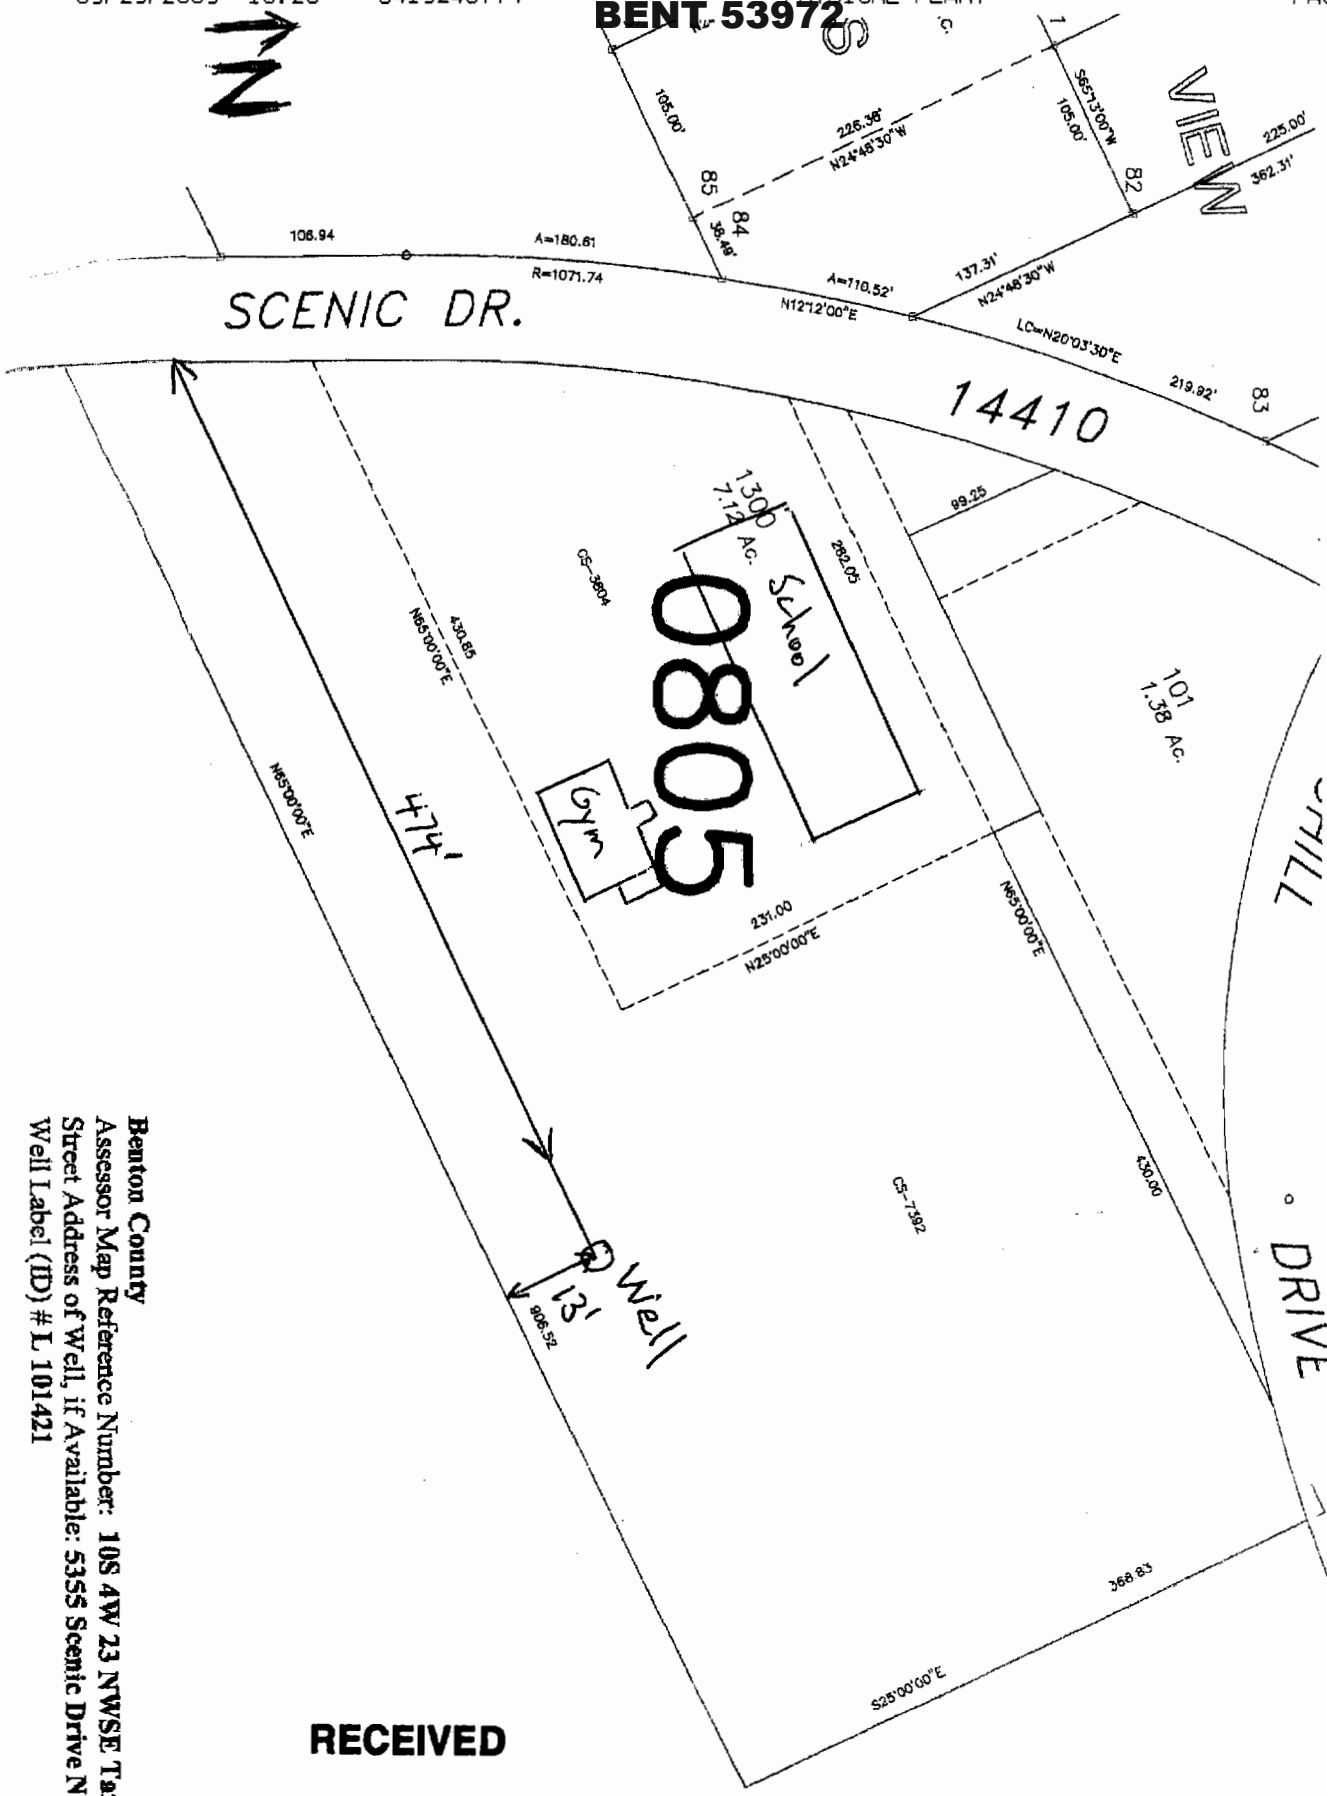

Benton County
 Assessor Map Reference Number: 10S 4W 23 NWSE Tax Lot 1300
 Street Address of Well, if Available: 5355 Scenic Drive NW, Albany, OR
 Well Label (ID) # L 101421

RECEIVED

SEP 29 2009

WATER RESOURCES DEPT
SALEM, OREGON

LAND OWNER SUBMITTED MAP