

LEGEND

- LINE TYPES
- TAX LOT BOUNDARY
- ROAD RIGHT-OF-WAY
- RAILROAD
- STREAM LAKE, ETC. TAX LOT BOUNDARY
- SUBDIVISION BOUNDARY
- TAX CODE BOUNDARY
- OLD PROPERTY LINE
- VACATED RIGHT-OF-WAY
- RAILROAD RIGHT-OF-WAY
- STREAM LAKE, ETC. NON-BOUNDARY
- PARTITION PLAT BOUND.
- ESSENT

SYMBOL TYPES

- DLIC
- CONTROL POINTS
- SURVEY MONUMENTS
- GLD CORNERS
- SECTION
- 1/4 SEC
- 1/8 SEC
- 1/16 SEC

NUMBERS  
TAX CODE NO.  
000 00 00 0


ABSTRACT - ALL ABSTRACTS EXCLUDE ANY PORTION THAT MAY LIE WITHIN THE INDICATED PUBLIC RIGHT OF WAY.

TICK MARKS - WHEN A TICK MARK IS INDICATED ON THE EXTENSION OF A LINE, THEN THE DIMENSION GIVEN TO THE TICK MARK, GENERALLY THIS IS USED WHEN DIMENSIONS GO INTO PUBLIC RIGHT OF WAY.

ARROWS ARE USED WITH DIMENSIONS IN AREAS OF GREATER COMPLEXITY.



SCALE 1" = 400'  
of 1:4000  
Plot file created: April 19, 2010

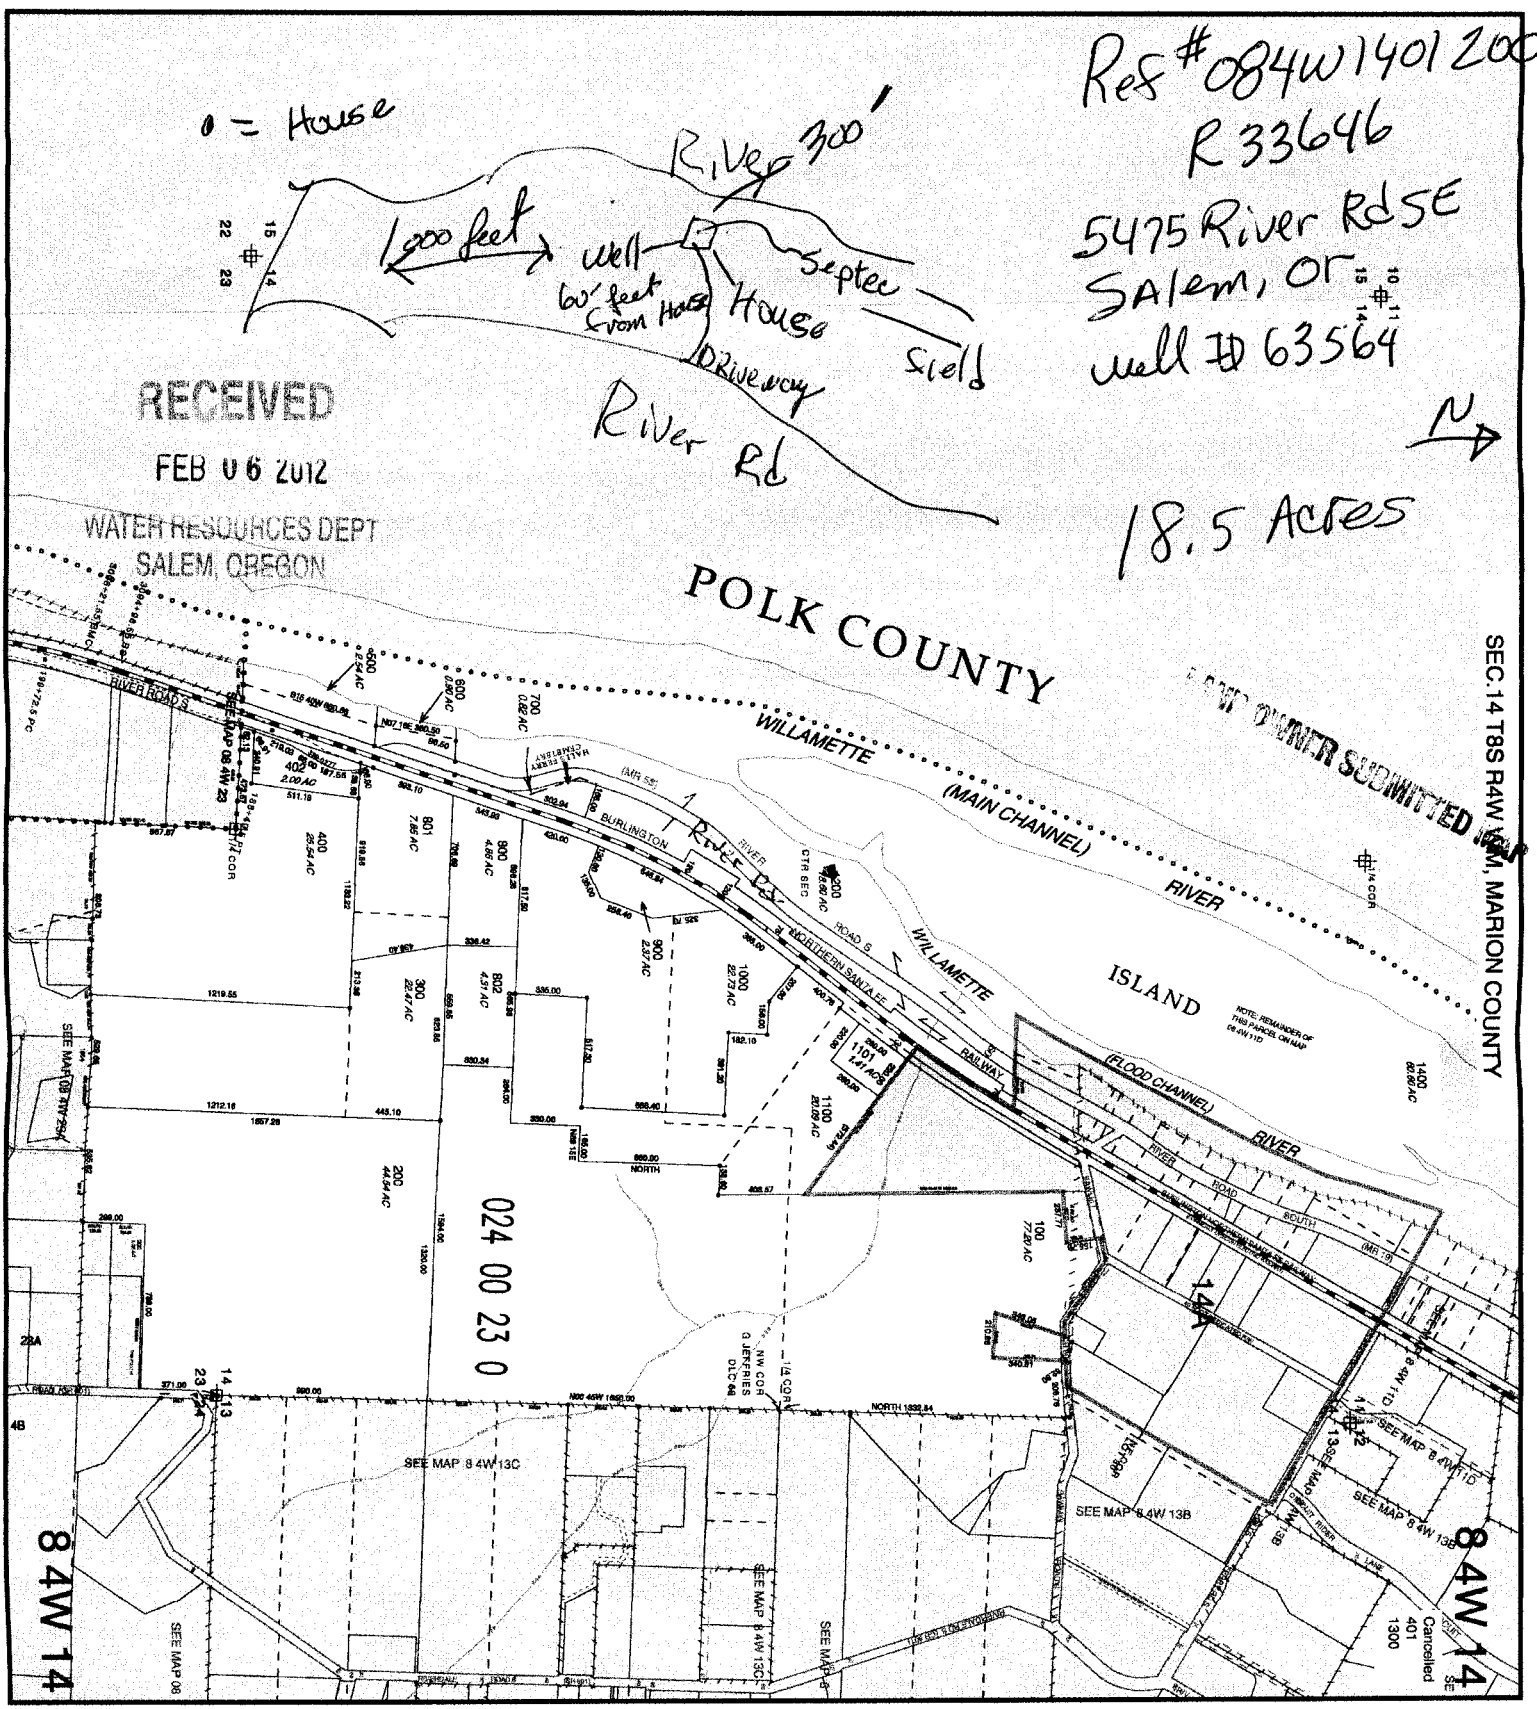

RECEIVED  
FEB 06 2012

WATER RESOURCES DEPT  
SALEM, OREGON

POLK COUNTY

Res # 084W1401200  
R33646  
5475 River Rd SE  
Salem, OR  
well # 63564  
18.5 Acres

SEC. 14 T8S R4W 14M, MARION COUNTY

84W14

84W14

024 00 23 0

SEE MAP 84W13C

SEE MAP 84W13B

SEE MAP 84W1D

SEE MAP 84W13B

SEE MAP 84W13C











