

70681
Ray W & Geraldine Harper
92684 River Rd
Junction City, OR 97448-9409


INV# Receipt#
1501040

SC# 204575

92950 River Road

N

Harper Road

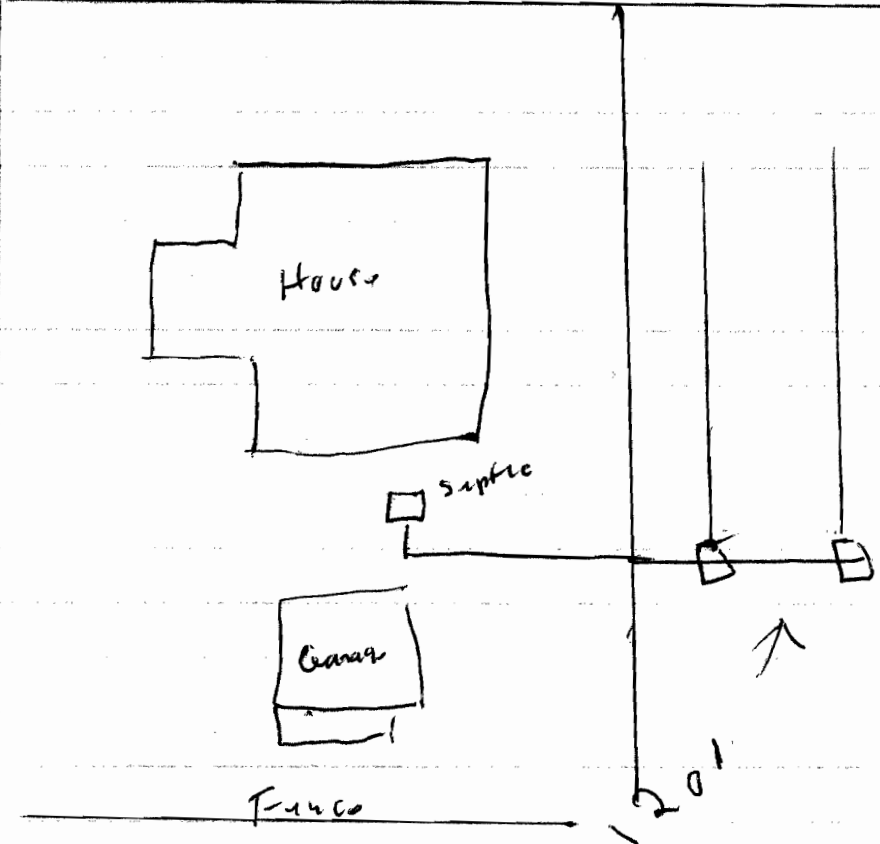

RECEIVED

AUG 25 2010

NATURAL RESOURCES DEPT
GALATIEN DISTRICT

← 25' → ○ well ←
to utility line

Property class 551
tax code area 06928 9.72 acres
Tax lot 16-04-09-00-02200

30020 Harper Rd
Junction City 97448

GPS location of well
44-11-184
123-10-196

LAND OWNER SUBMITTED MAP