


OWRD Basic Web Mapping Application (beta)

Latitude: 44.664348 , Longitude: -123.064  
Oregon Lambert Coordinate: 645455.97, 10

- OWRD Data
- Base Data
- Imagery

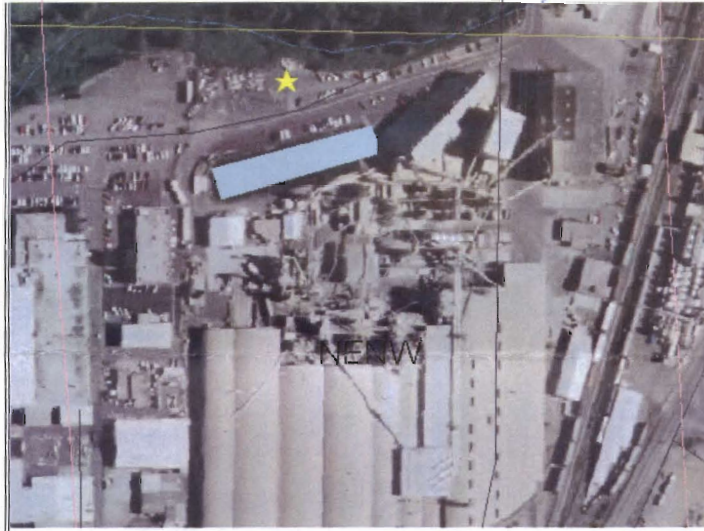

TRSQQ: 10.00S-03.00W-33-NENW


County: Linn  
 Basin: Willamette  
 WM District: 2  
 WM Region: NW  
 Withdrawn Area:  
 WAB: [WILLAMETTE R > COLUMBIA R - / 14191000 \(183\)](#)  
 Priority WAB:  
 Rule 4D: Rules apply  
 Groundwater  
 Restricted:  
 Scenic Water Way:  
 Division 33: LOWER COLUMBIA  
 Water Quality Limited: Yes  
 Water Rights: [See Water Rights in this section \(](#)  
 Well Logs: [See Well Logs in this section](#)

RECEIVED

AUG 11 2010

WATER RESOURCES DEPT  
SALEM, OREGON

LAND OWNER SUBMITTED MAP

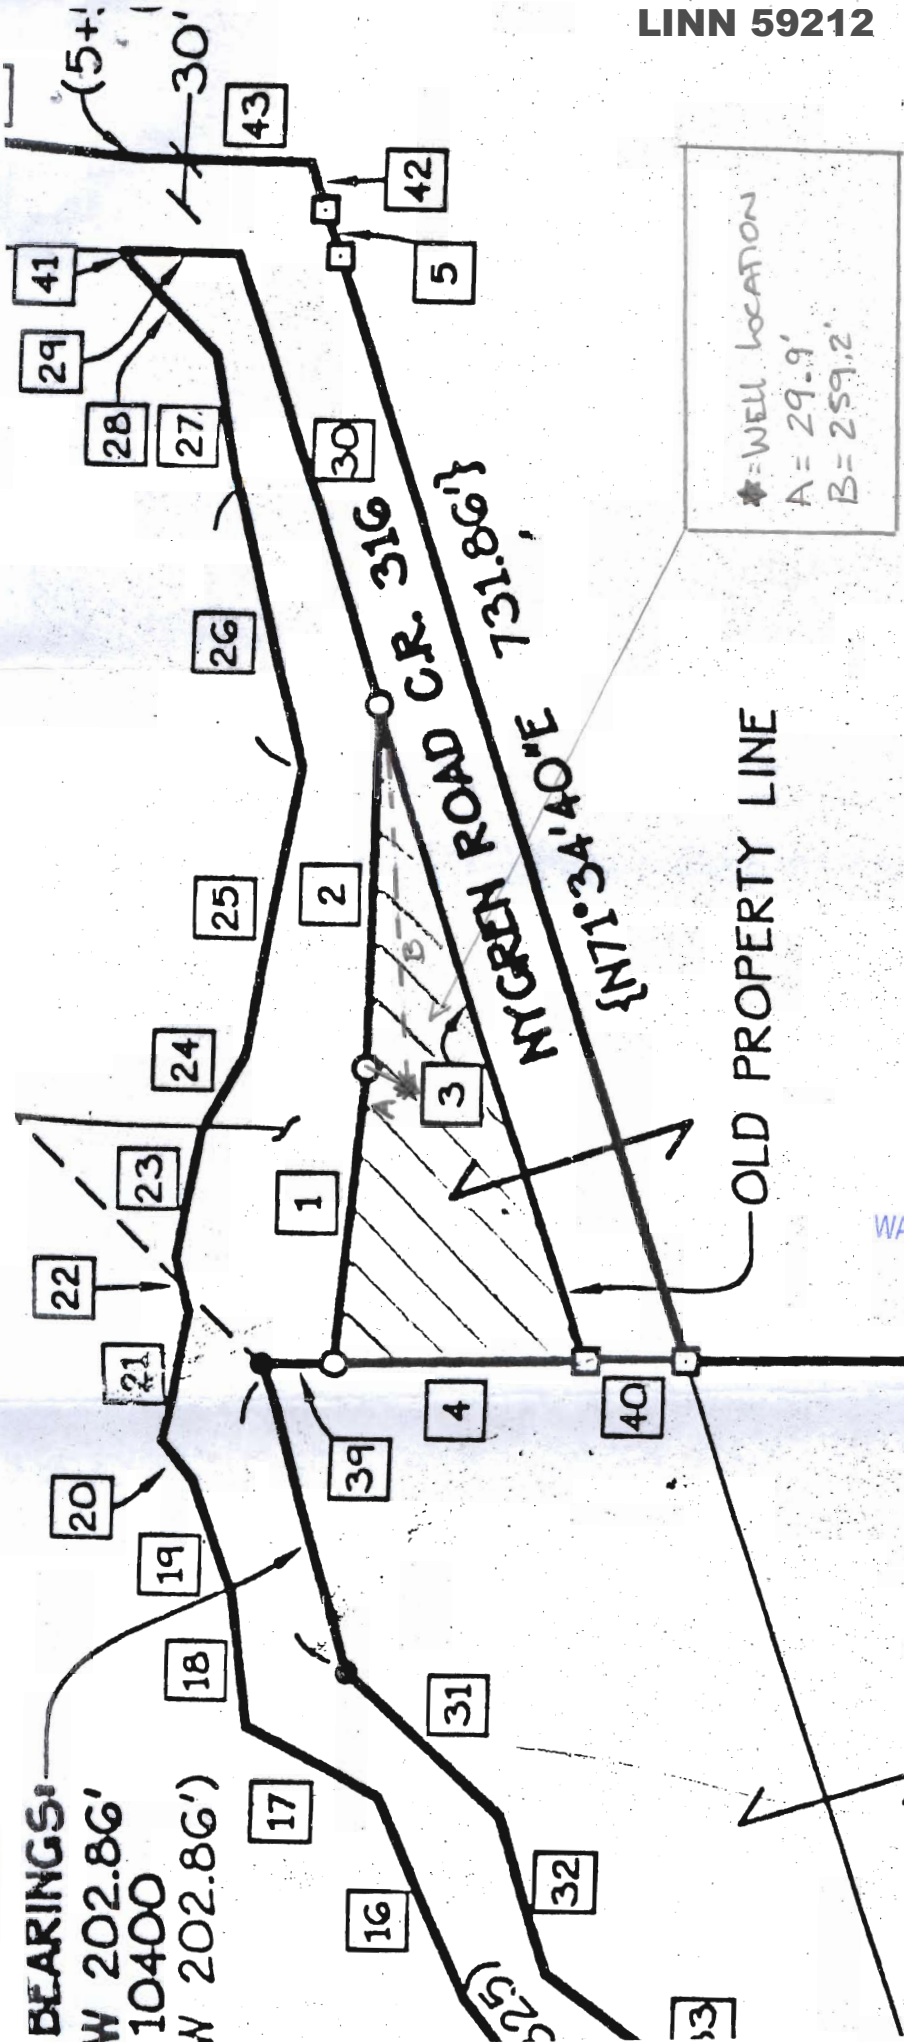

RECEIVED  
 AUG 11 2010  
 WATER RESOURCES DEPT  
 SALEM, OREGON

LAND OWNER SUBMITTED MAP

**PROPERTY "A"**

1 CHANG TRACT  
 20K 343, PAGE 859)

(WEYERHAEUSER TRACT PER MF 1586-311)

ORIGINAL AREA	22.45 ACRES
ADJUSTMENT	+0.72 ACRES
NEW AREA	23.17 ACRES

{N1°10'00"E 882.66'}