



**STREET**

**SHAW STREET  
NO. 7423**

**2700**  
**2600**

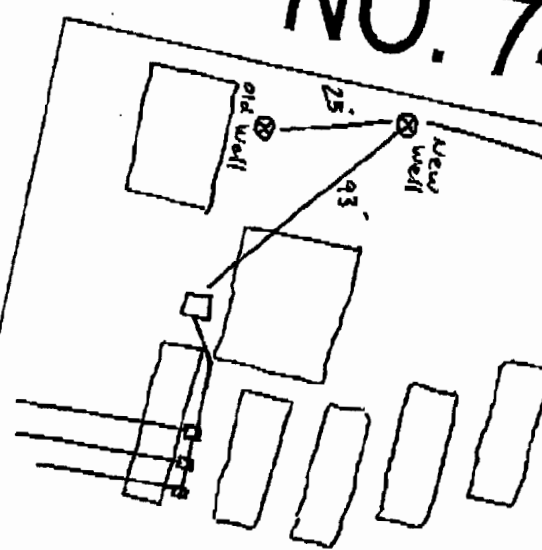

This map was produced using the Polk County GIS data. The GIS data is maintained by the county to support the governmental activities. The county is not responsible for any errors, omissions, misuses or misinterpretations.

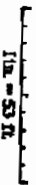

6/23/2010




**RECEIVED**

FEB 09 2011

WATER RESOURCES DEPT  
SALEM, OREGON

7.4.25D  
 Sand  
 GRAVEL  

Polk County Map