


RECEIVED
 MAR 09 2011

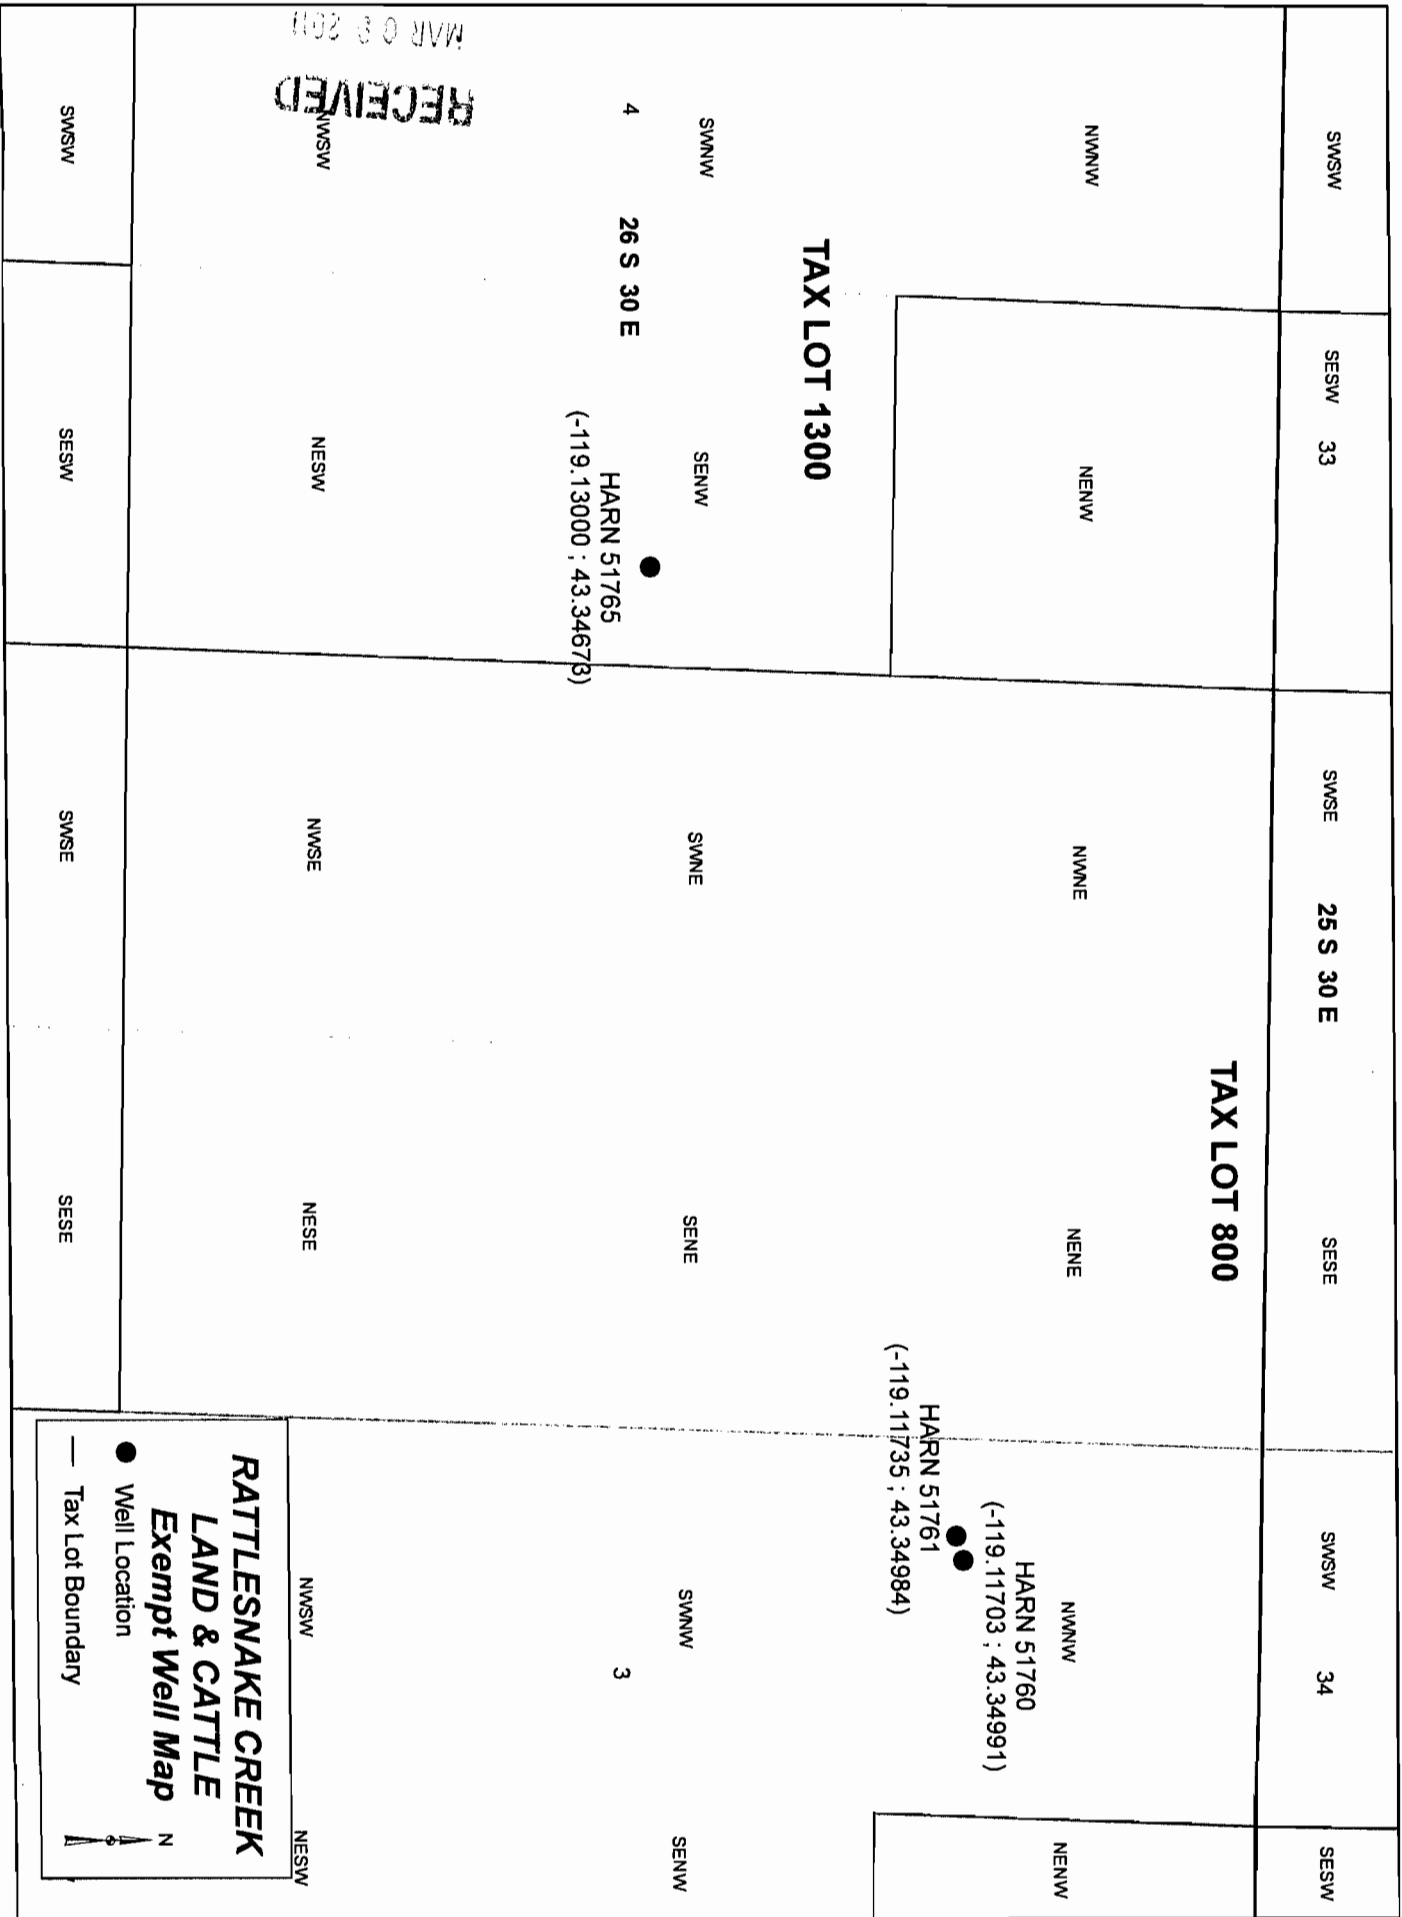

**RATTLESNAKE CREEK
 LAND & CATTLE
 Exempt Well Map**

● Well Location
 — Tax Lot Boundary

N
 ↑