


# EXEMPT USE WELL LOCATION MAP

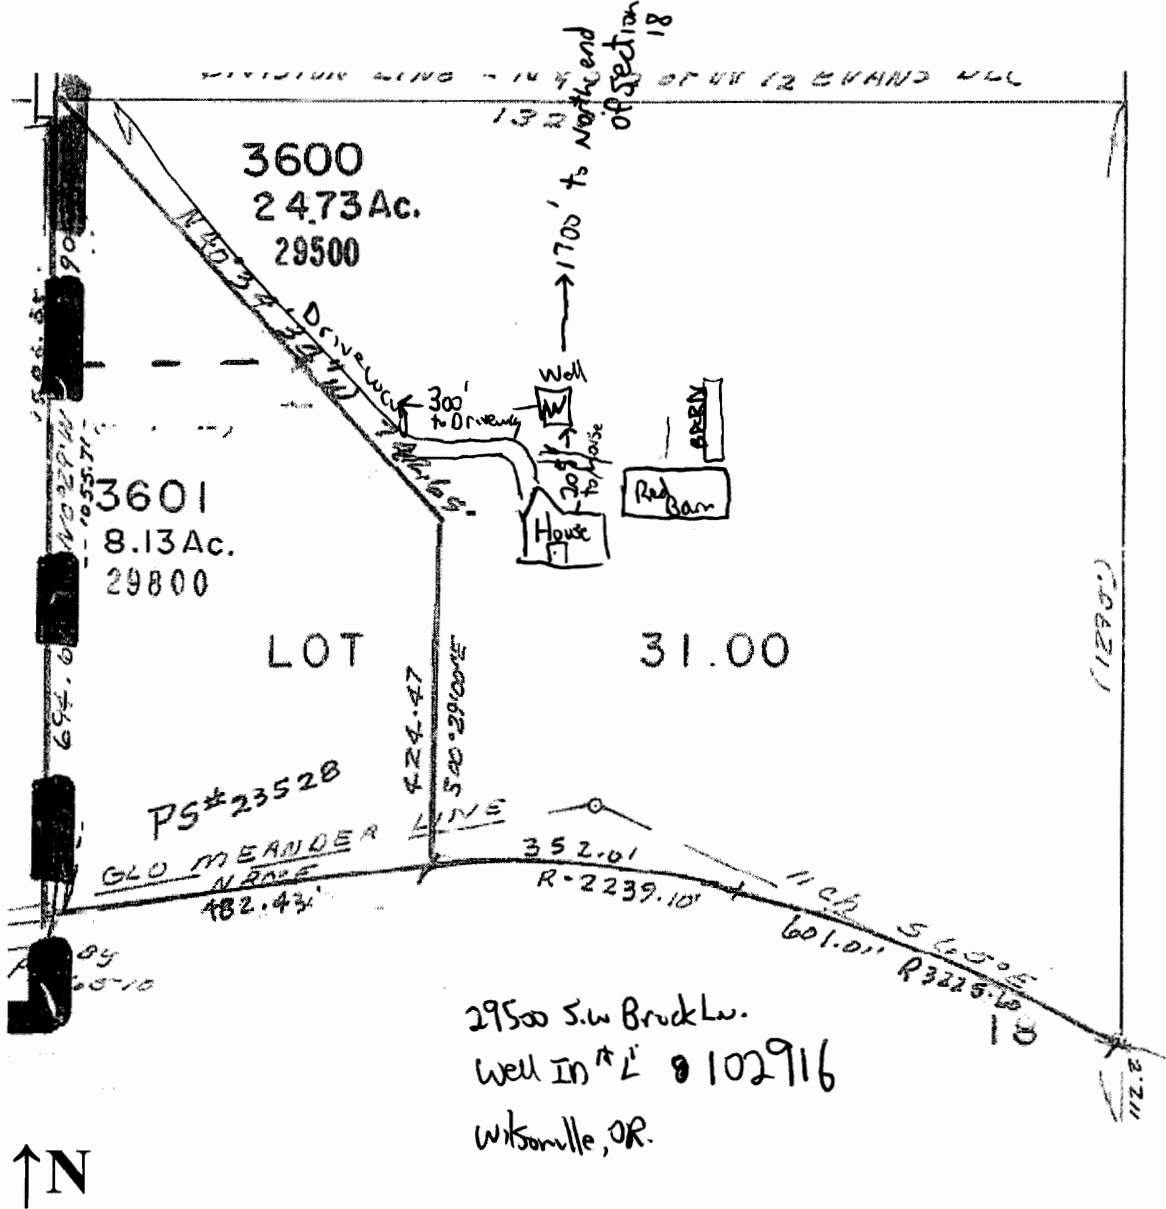

**Clackamas County**

Assessor Map Reference Number: 3S 1E 18 SENW; Tax Lot 3600.

Street Address of Well, if Available: 29500 Bruck Lane, Wilsonville, OR.

Well Log #: CLAC 66879. Well Label (ID Tag) #: L 102916. (Please Locate Well and Indicate distance From Property or Survey Corner, See Attached Sample Well Location Map.) You may also locate your well using our exempt use well mapping tool on our website at [www.wrd.state.or.us/OWRD/exempt\\_use\\_788\\_info.shtml](http://www.wrd.state.or.us/OWRD/exempt_use_788_info.shtml) or by contacting the Exempt Use Well Program Coordinator at 503 986-0861.

MAP NOT TO SCALE

**RECEIVED**

JUN 22 2010

LAND OWNER SUBMITTED MAP WATER RESOURCES DEPT  
SALEM, OREGON