

1100111 AN SUBMITTAL FORM

Use this sheet for your drawings.

OWNER ADDRESS:

APPLICANT NAME:
KEVIN & TONYA RAVEN

APPLICANT PHONE #:
541 - 895-2408


APPLICANT ADDRESS:

02-07 LOT #1201

1106.82

786.12

PLANE 71047

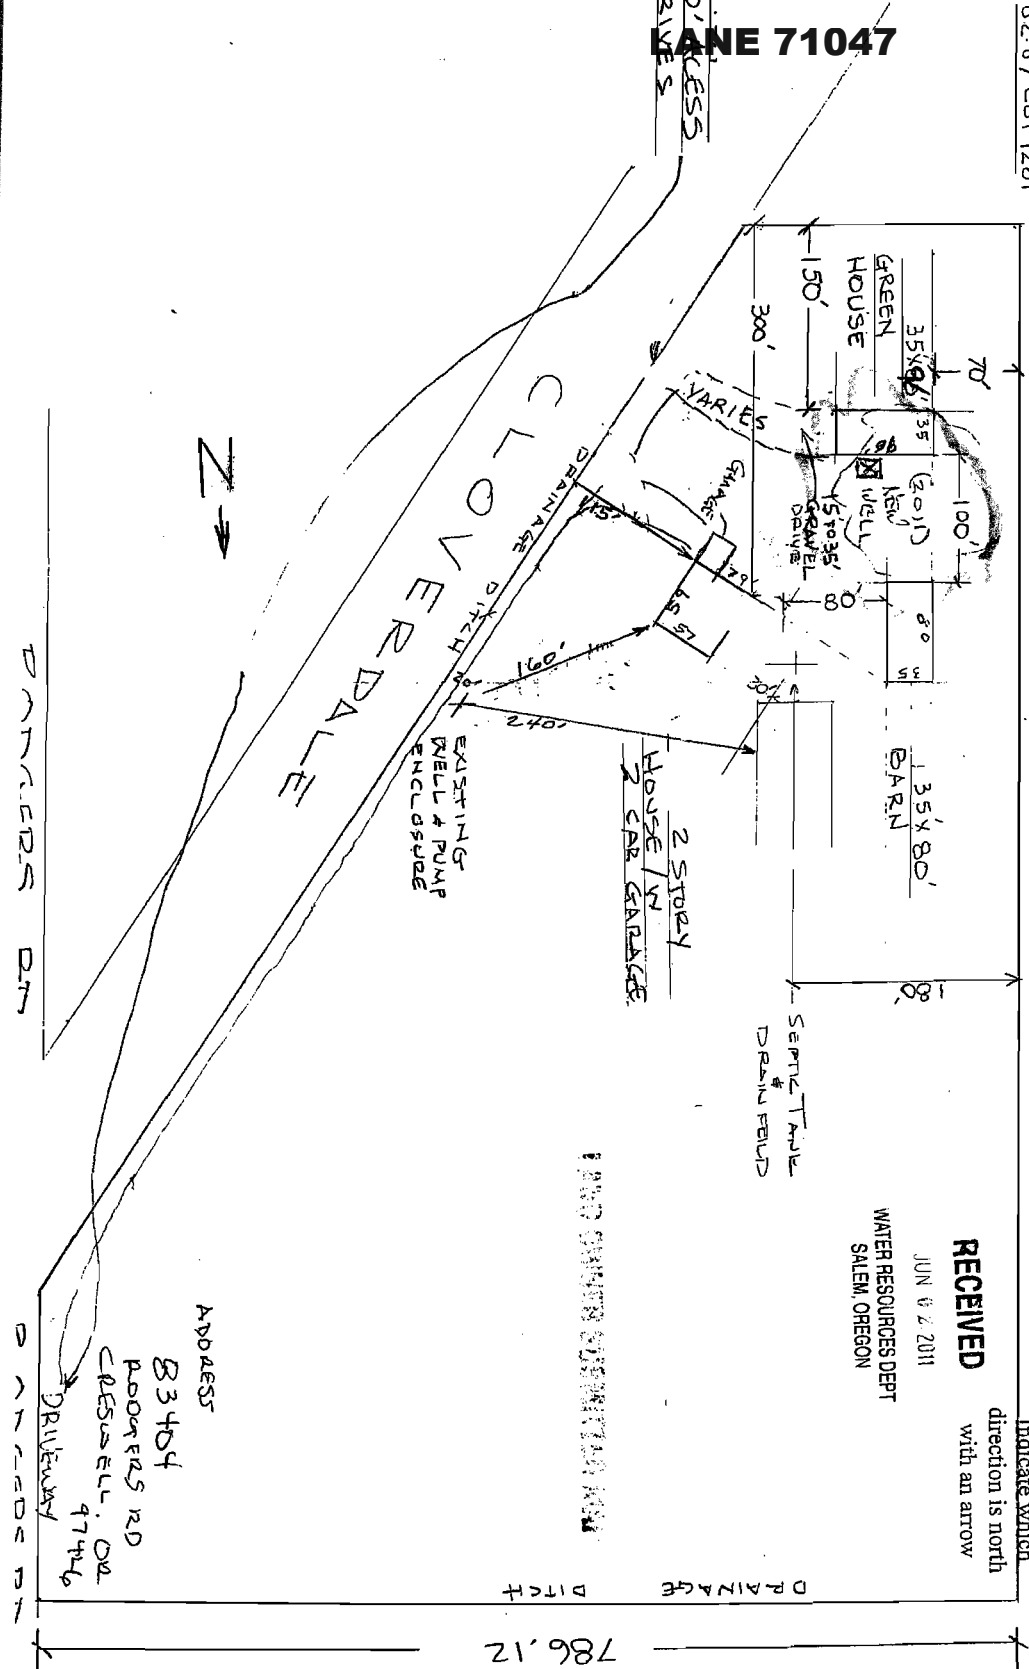

RECEIVED

JUN 02 2011

WATER RESOURCES DEPT
SALEM, OREGON

Indicate which
direction is north
with an arrow

ADDRESS

83404

ADORNERS RD

CLISSILL, OR

97146

Drillway

DANNERS DR

DANNERS DR

N →