

MARI 63906

LEGEND

LINE TYPES

- LOT BOUNDARY
- OLD PROPERTY LINE
- RIGHT-OF-WAY
- VACATED RIGHT-OF-WAY
- ROAD
- RAILROAD RIGHT-OF-WAY
- LAKES, ETC.
- LOT BOUNDARY
- STREAM, LAKE, ETC.
- NON-BOUNDARY
- XYLON BOUNDARY
- PARTITION PLAT BDT.
- CODE BOUNDARY
- EASEMENT

SYMBOL TYPES

- D.L.C.
- CONTROL POINTS
- SURVEY MONUMENTS
- CL.A. CORNERS
- 1/4 SEC.
- 1/16 SEC.

NUMBERS

TAX CODE NO.
000 00 00 0

ACREAGE - ALL ACREAGES EXCLUDE ANY PORTION THAT MAY BE WITHIN THE INDICATED PUBLIC RIGHT OF WAY.


TICK MARKS - WHEN A TICK MARK IS INDICATED ON THE EXTENSION OF A LINE, THEN THE DIMENSION COMES TO THE TICK MARK. GENERALLY THIS IS USED WHEN DIMENSIONS GO INTO PUBLIC RIGHT OF WAY.

ARROWS ARE USED WITH DIMENSIONS IN AREAS OF GREATER COMPLEXITY.

NOTICE: This map was created for Assessor's Office use ONLY.

Assessor "The Care" GIS Geographic Information System

SCALE 1" = 100' or 1:1200
Title created: August 10, 2011
MAR639062W18C00

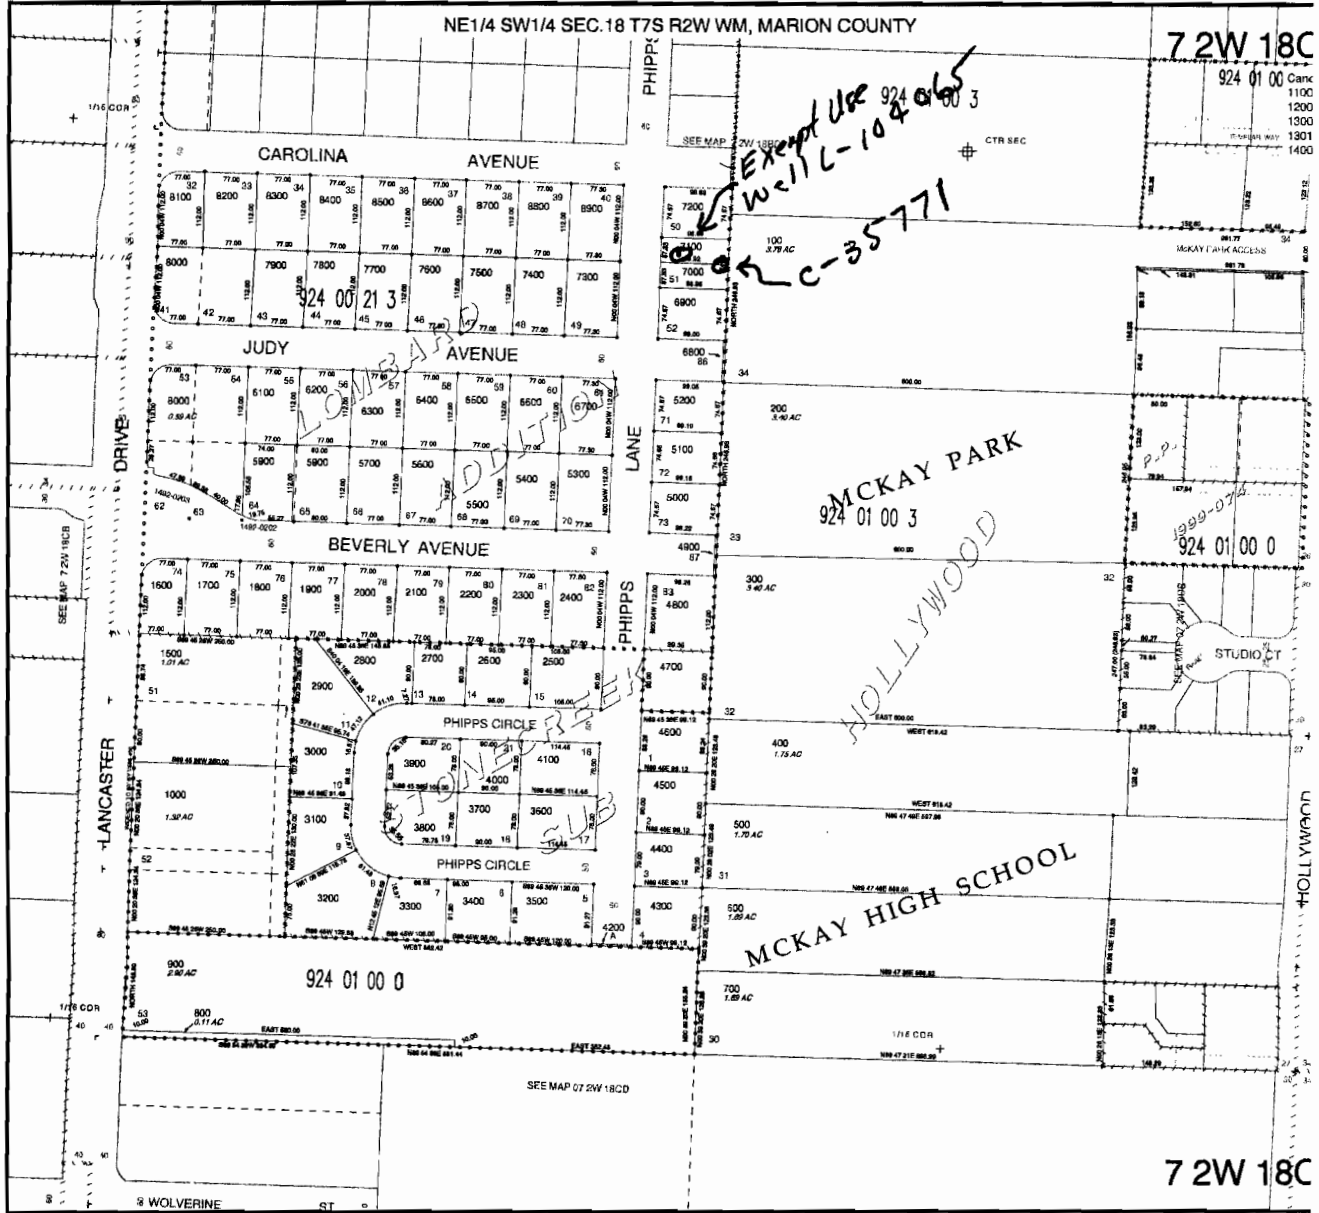

Scale: 1" \approx 300'

RECEIVED

NOV 17 2011

WATER RESOURCES DEPT
SALEM, OREGON

OWNER SUBMITTED MAP

5

LOMBARD ADDITION

SECTION 18 T.7S.R.2W.

SURVEYORS CERTIFICATE

DEDICATION

KNOW ALL MEN BY THESE PRESENTS:








Justice of the Peace
County of Marion, Oregon

Shows well for C-35771.
Exempt Use Well L-104065
is 60 ft west + 10 ft north
of said well.

Application No. G-247
Permit No. 6-153

RECEIVED

NOV 17 2011

LAND OWNER SUBMITTED MAP

WATER RESOURCES DEPT
SALEM, OREGON