

RECEIVED

SECTION PLAT

MAR 21 2012

WATER RESOURCES DEPT
SALEM, OREGON

Section 2E10


Township 23S

Range 31E

County of Harney

State of Oregon

NORTH

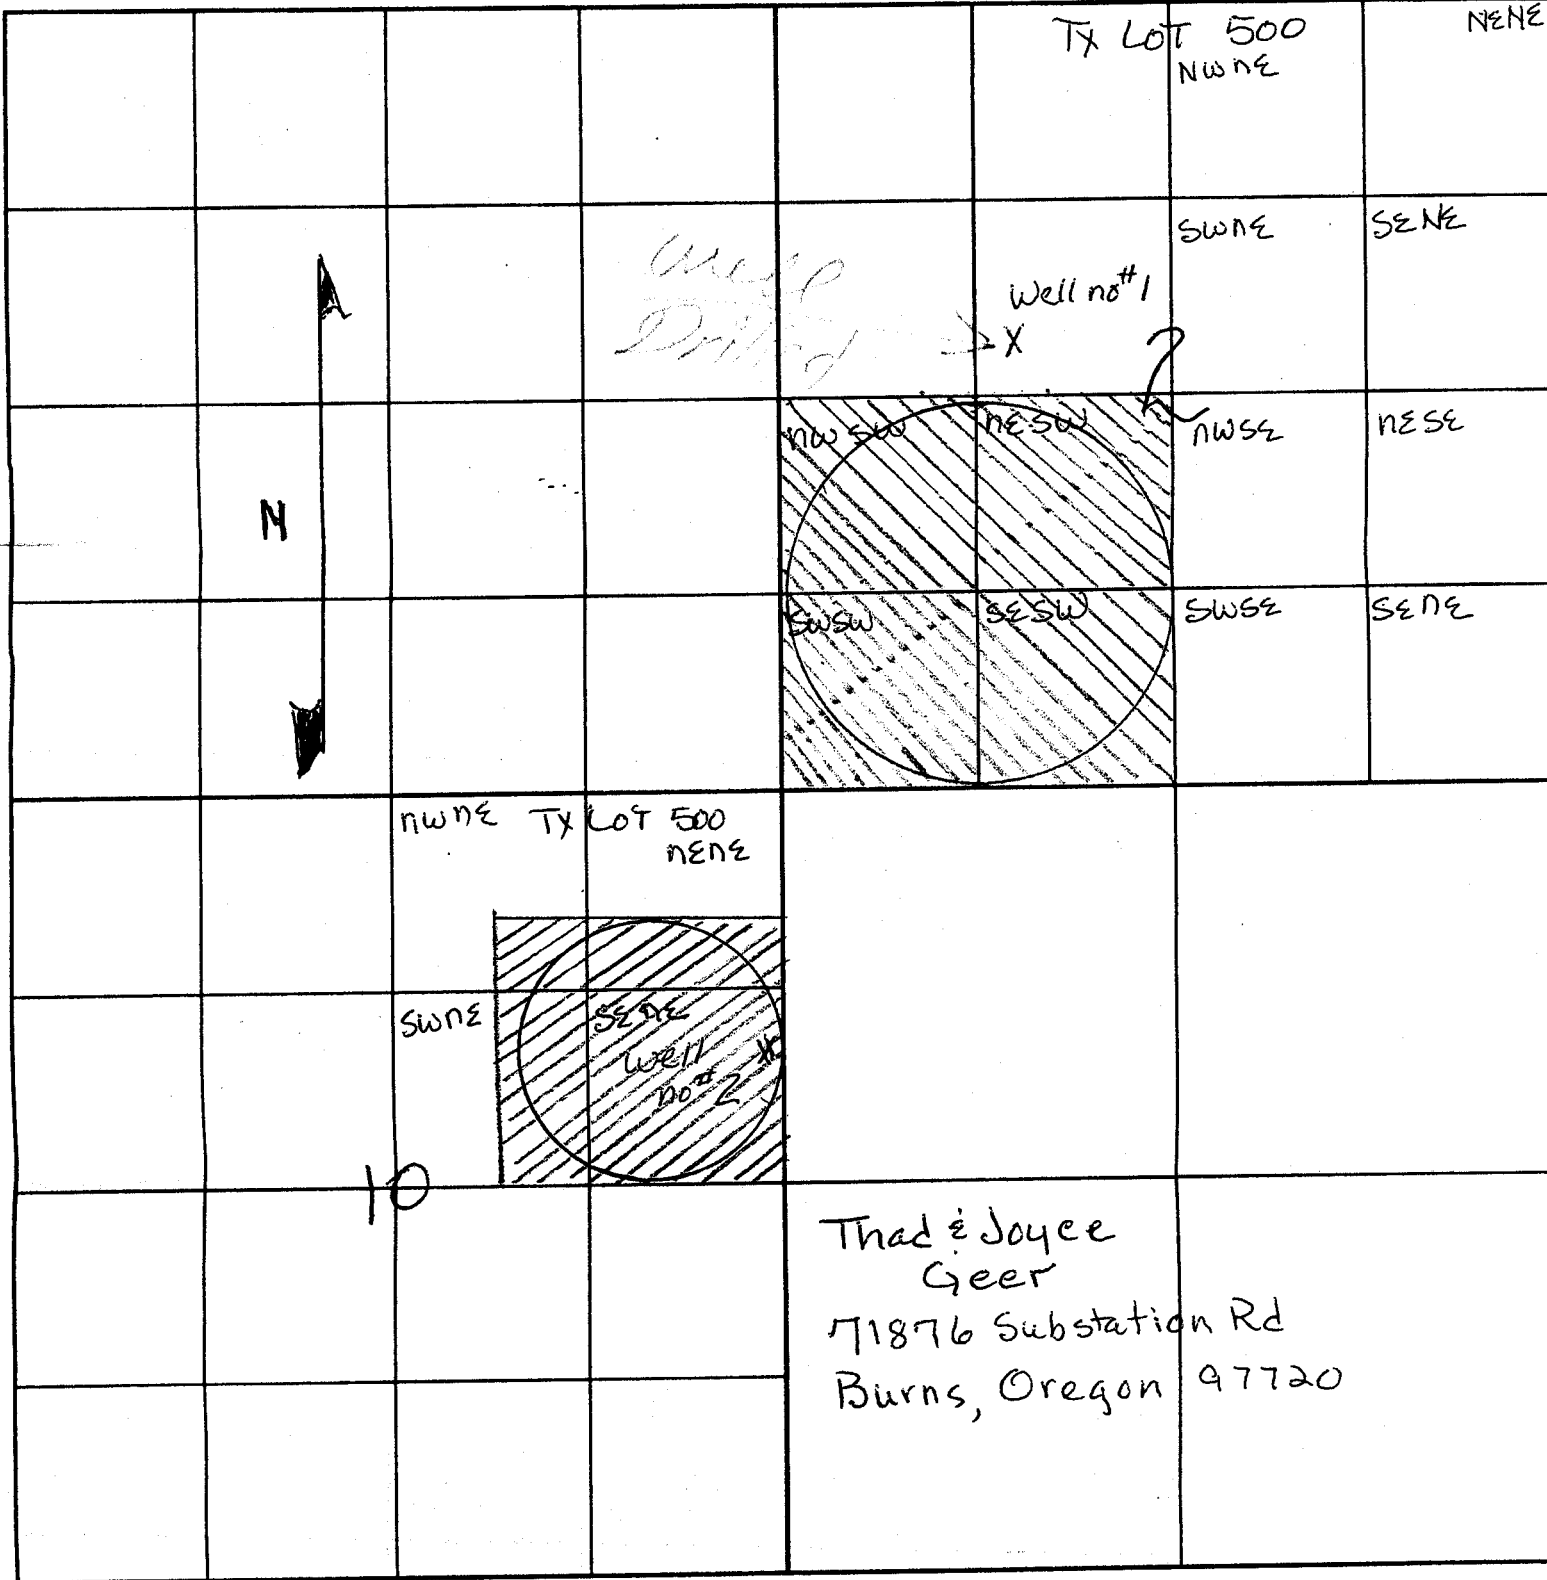

4"=1 mile