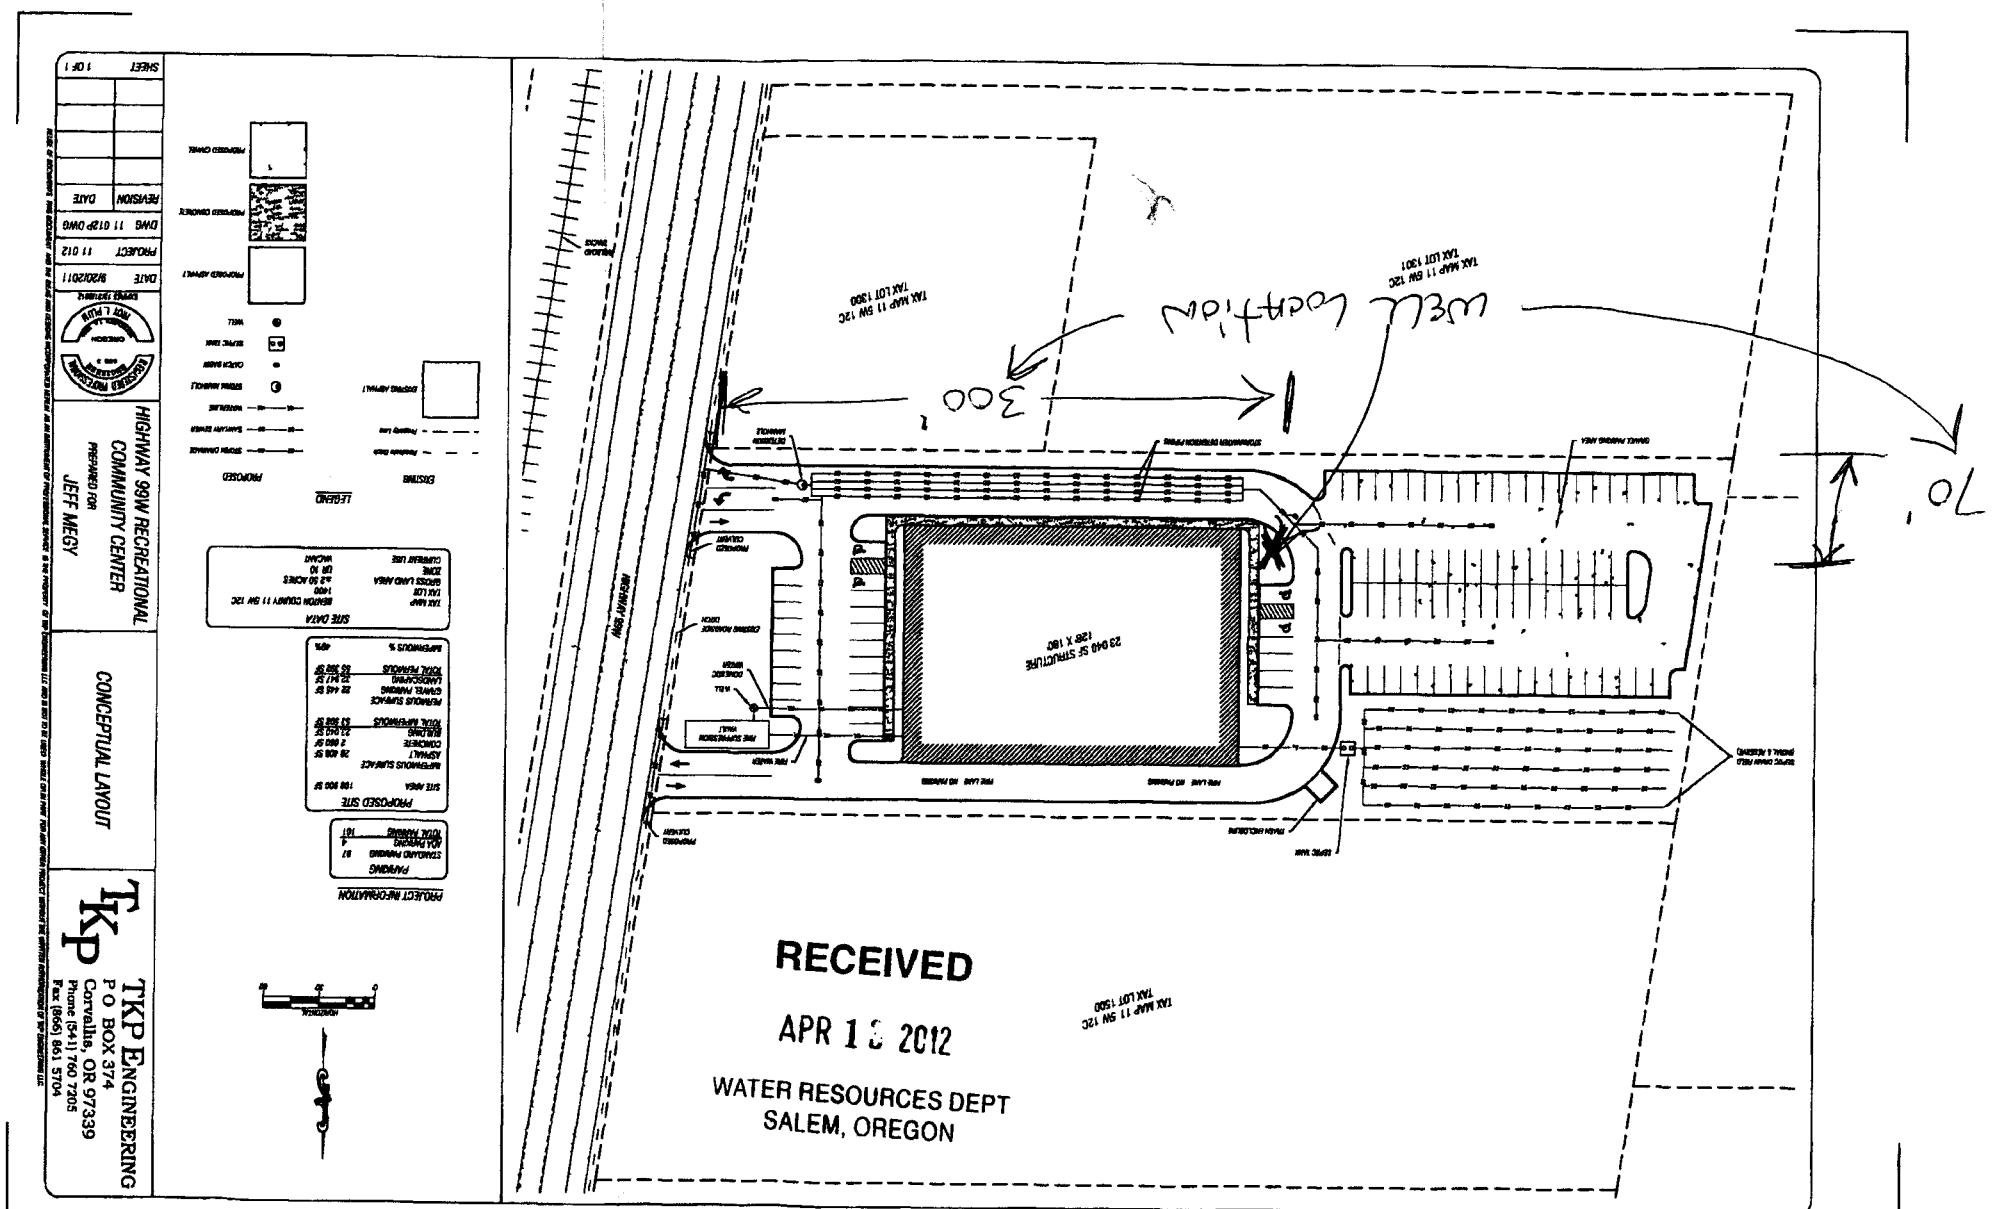

APPLICANT SUBMITTED MAP