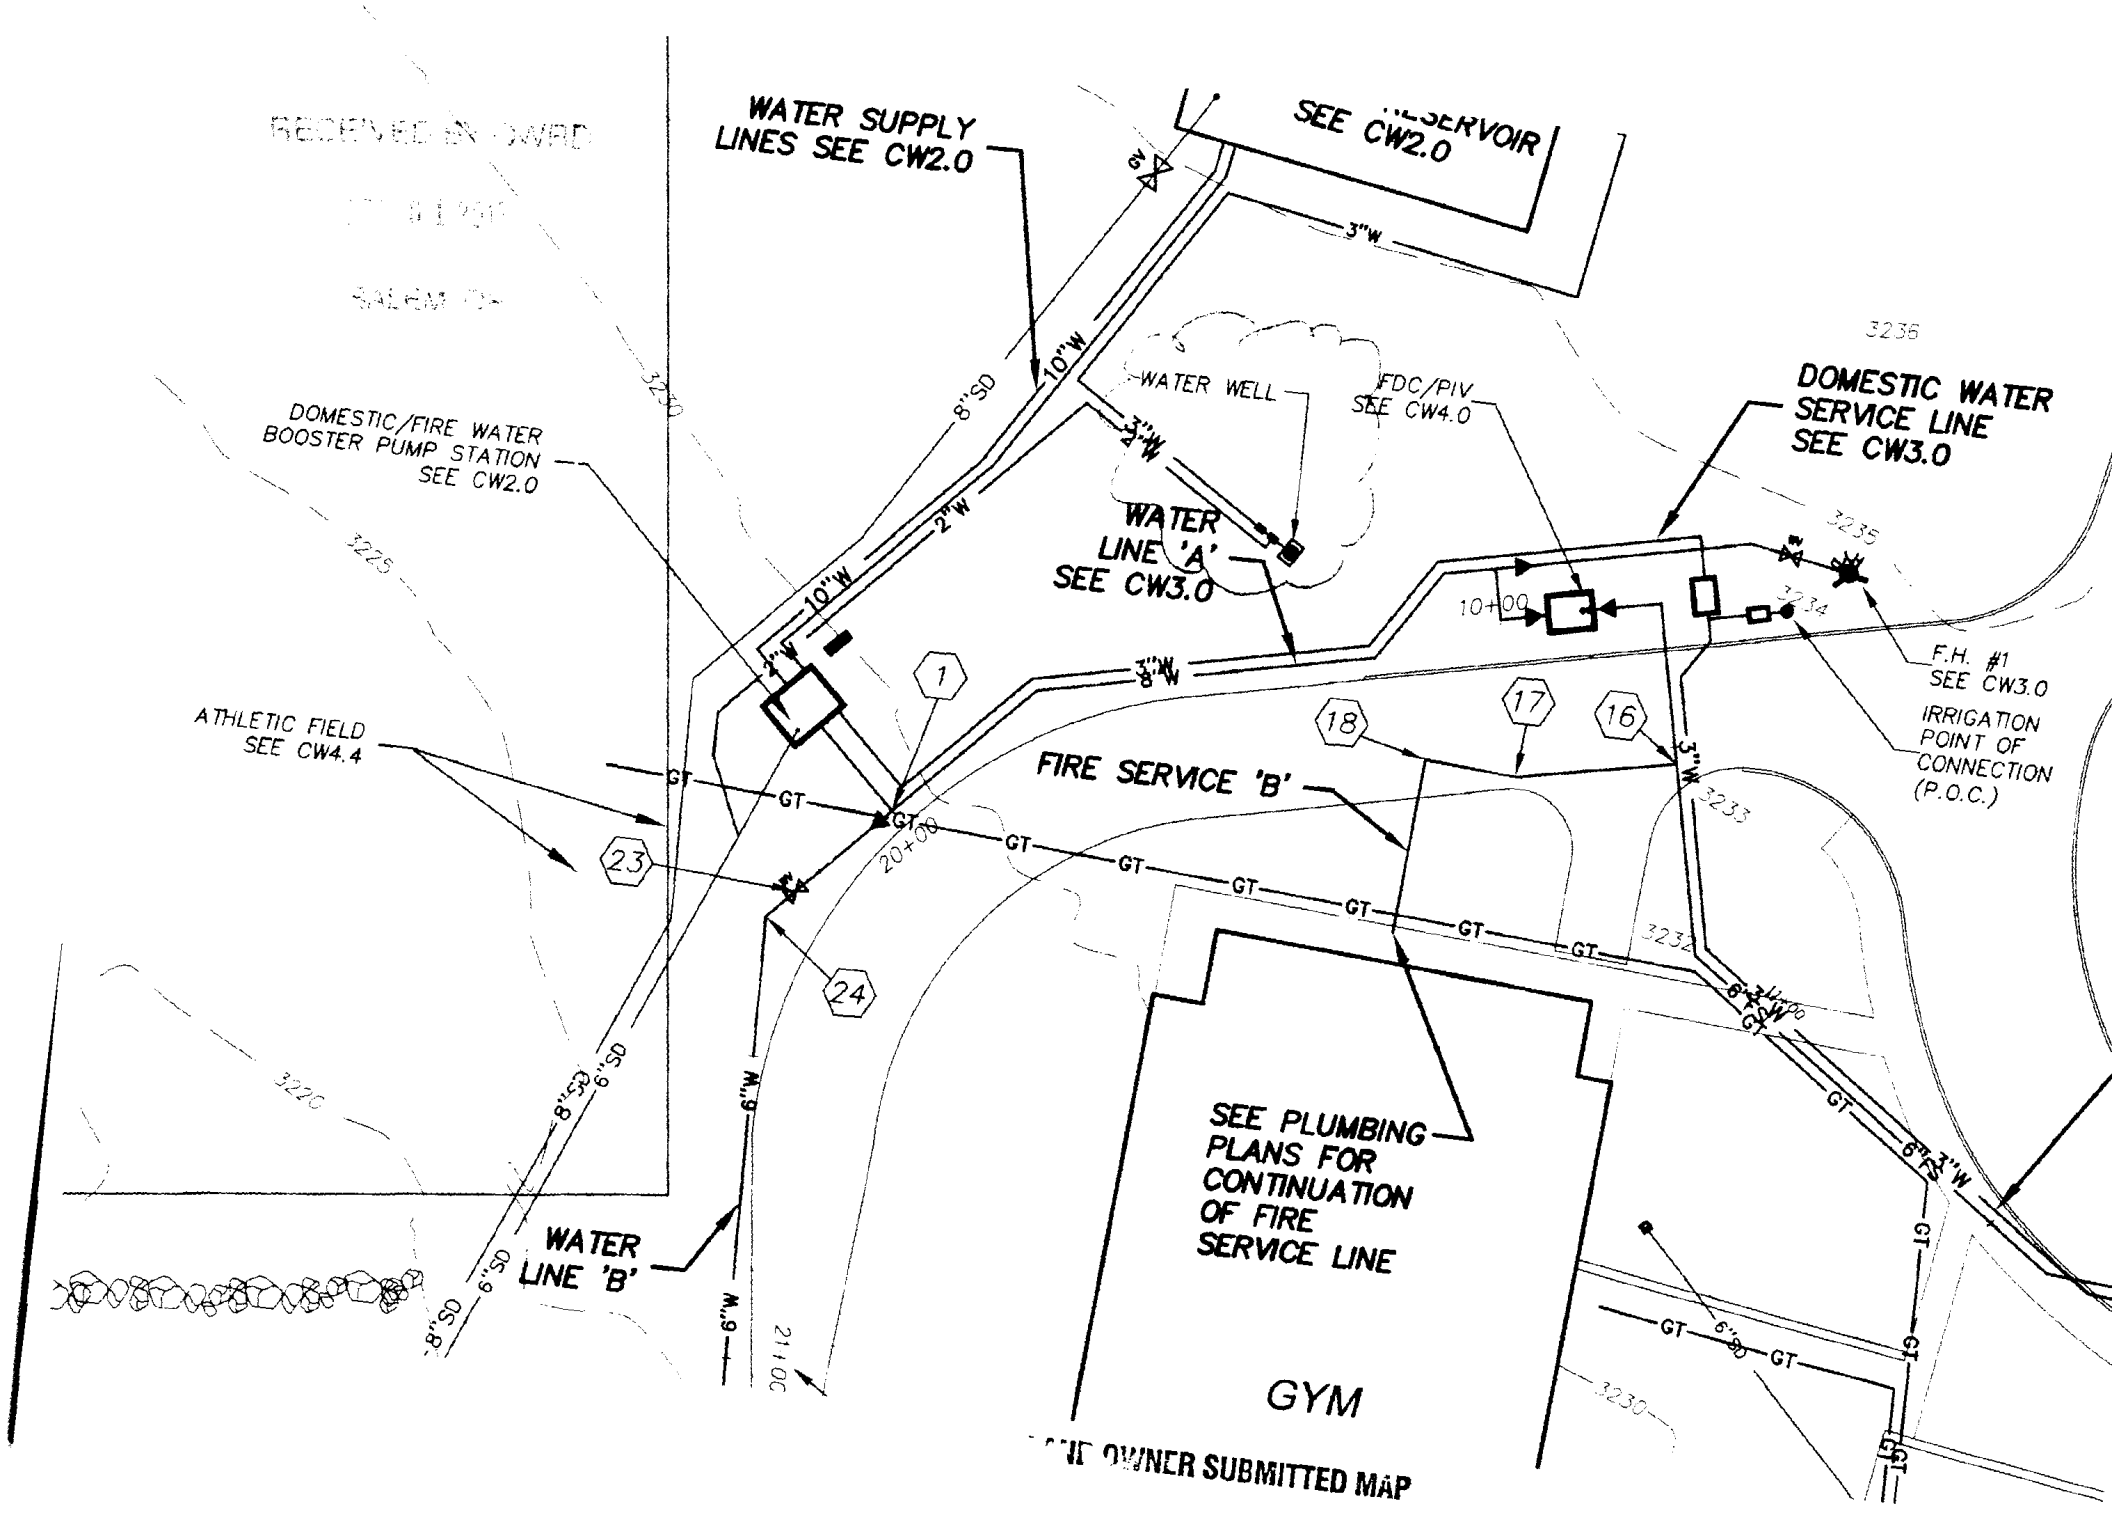
WATER SUPPLY LINES SEE CW2.0
SEE CW2.0
3"W
8"SD
10"W
2"W
WATER WELL
FDC/PIV SEE CW4.0
DOMESTIC WATER SERVICE LINE SEE CW3.0
DOMESTIC/FIRE WATER BOOSTER PUMP STATION SEE CW2.0
WATER LINE 'A' SEE CW3.0
10+00
F.H. #1 SEE CW3.0
IRRIGATION POINT OF CONNECTION (P.O.C.)
ATHLETIC FIELD SEE CW4.4
FIRE SERVICE 'B'
1
16
17
18
23
24
GT
20+00
6"SD
8"SD
6"W
WATER LINE 'B'
SEE PLUMBING PLANS FOR CONTINUATION OF FIRE SERVICE LINE
GYM
3236
3235
3234
3233
3232
3230
3225
3220
OWNER SUBMITTED MAP