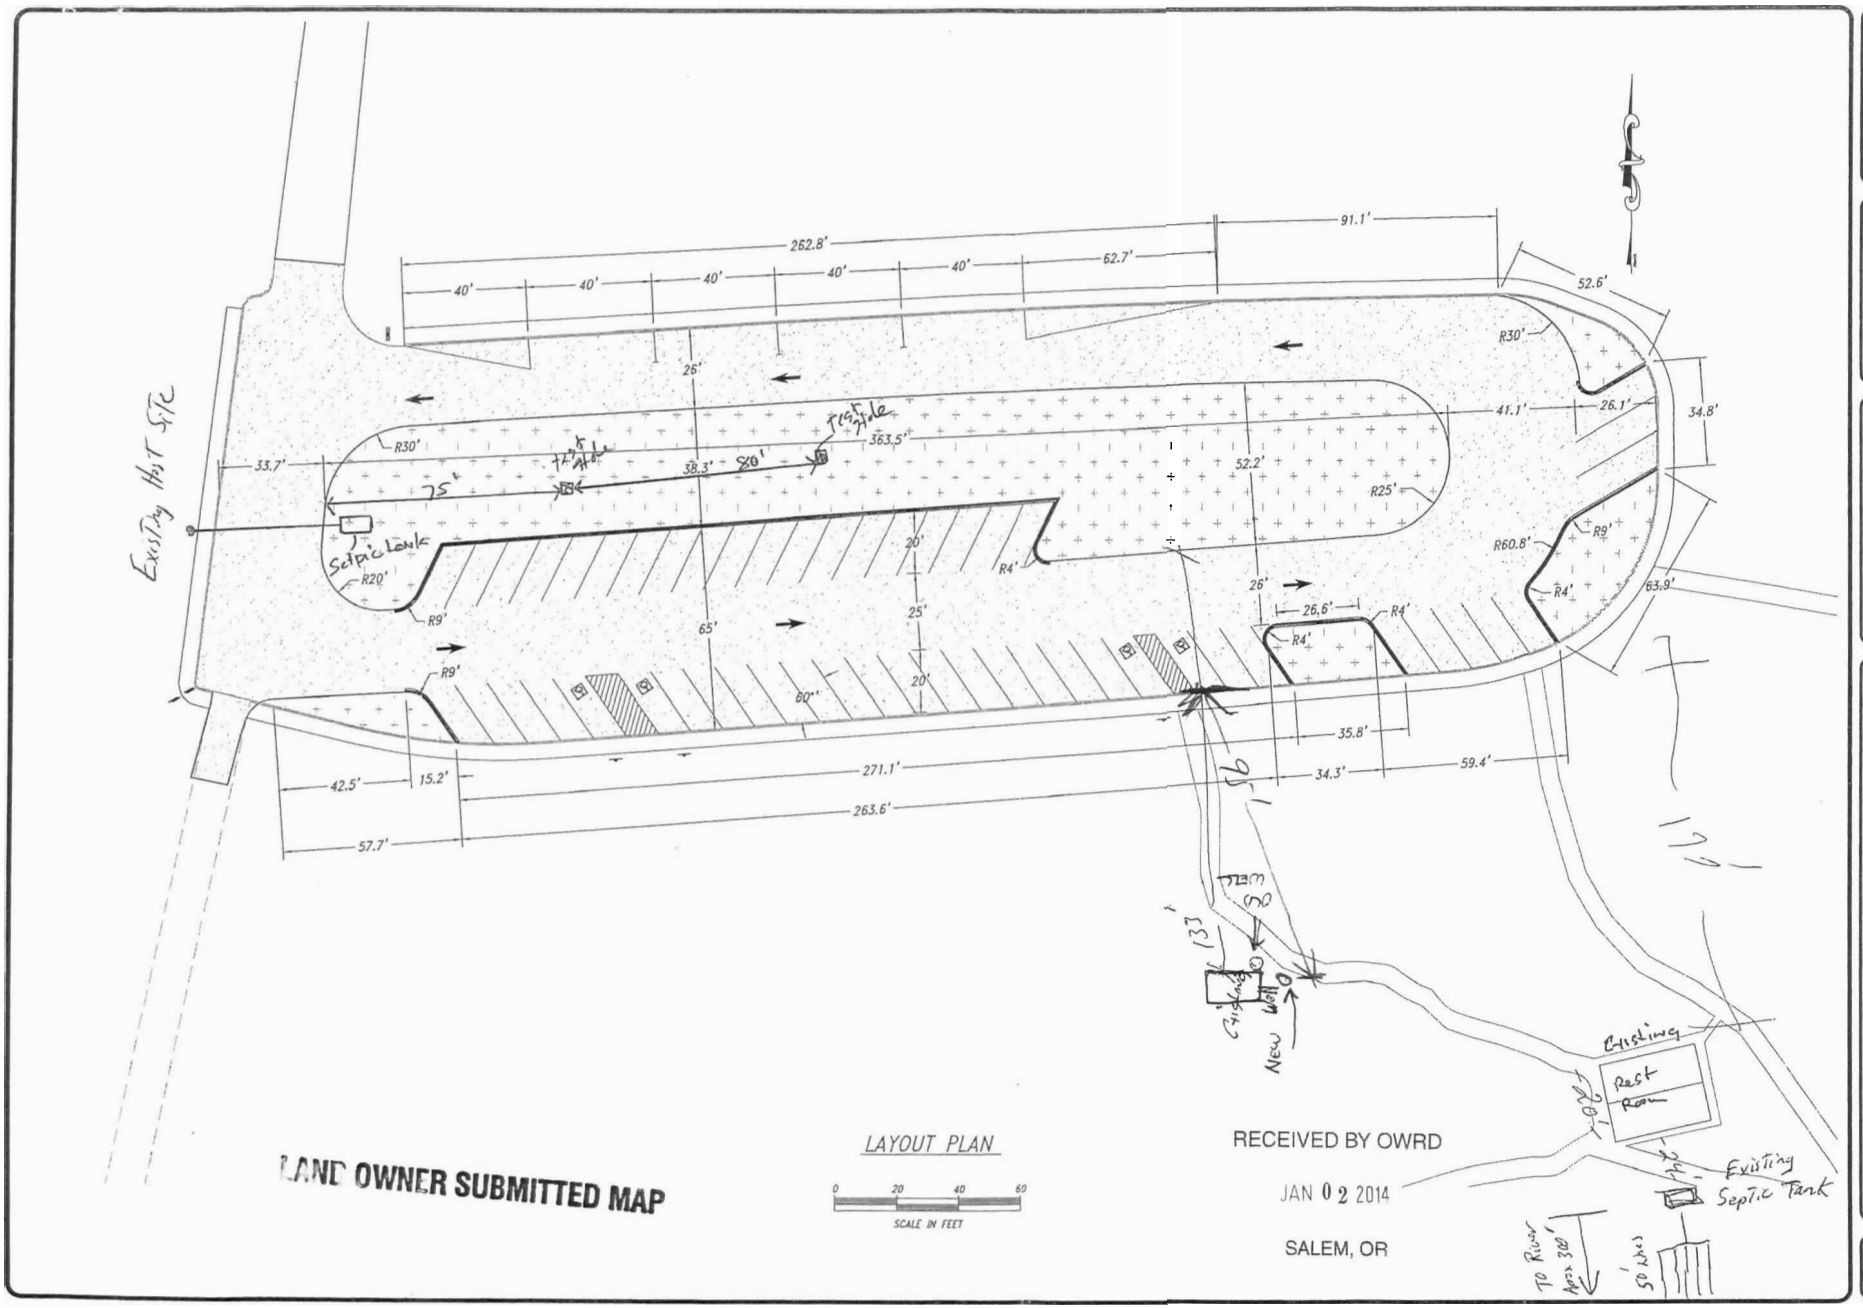

LAND OWNER SUBMITTED MAP

LAYOUT PLAN

0 20 40 60
SCALE IN FEET

RECEIVED BY OWRD
JAN 02 2014
SALEM, OR

REVISION	DATE	BY

APPROVED BY
CHECKED BY
DESIGNED BY D.BUCHANAN
DRAWN BY D.BUCHANAN DATE 7/26/06

OREGON STATE PARKS

LAYOUT PLAN
PAVEMENT OVERLAY PROJECT
AT NORTH SANTIAM STATE RECREATION AREA

OREGON PARKS AND RECREATION DEPARTMENT

SHEET: 4 OF 5
FILE: NSD6-253-4