STATE OF OREGON
WELL LOCATION MAP

This map is supplemental to the WATER SUPPLY WELL REPORT

Oregon Water Resources Department
725 Summer St NE, Salem OR 97301
(503)986-0900

LOCATION OF WELL

Latitude: 44.35972 Datum: WGS84

Longitude: -121.6603

Township/Range/Section/Quarter-Quarter Section:

WM 14S 9E 16 SENE

Address of Well:

13511 HAWKS BEARD

BLACK BUTTE RANCH

Revised: 13511 Hawks Beard

Black Butte Ranch, Sisters

Well Label: L112240

Well Log: DESC 59906

Printed: April 19, 2017

DISCLAIMER: This map is intended to represent the approximate location of the exempt use well provided by the land owner. It is not intended to be construed as survey accurate in any manner.
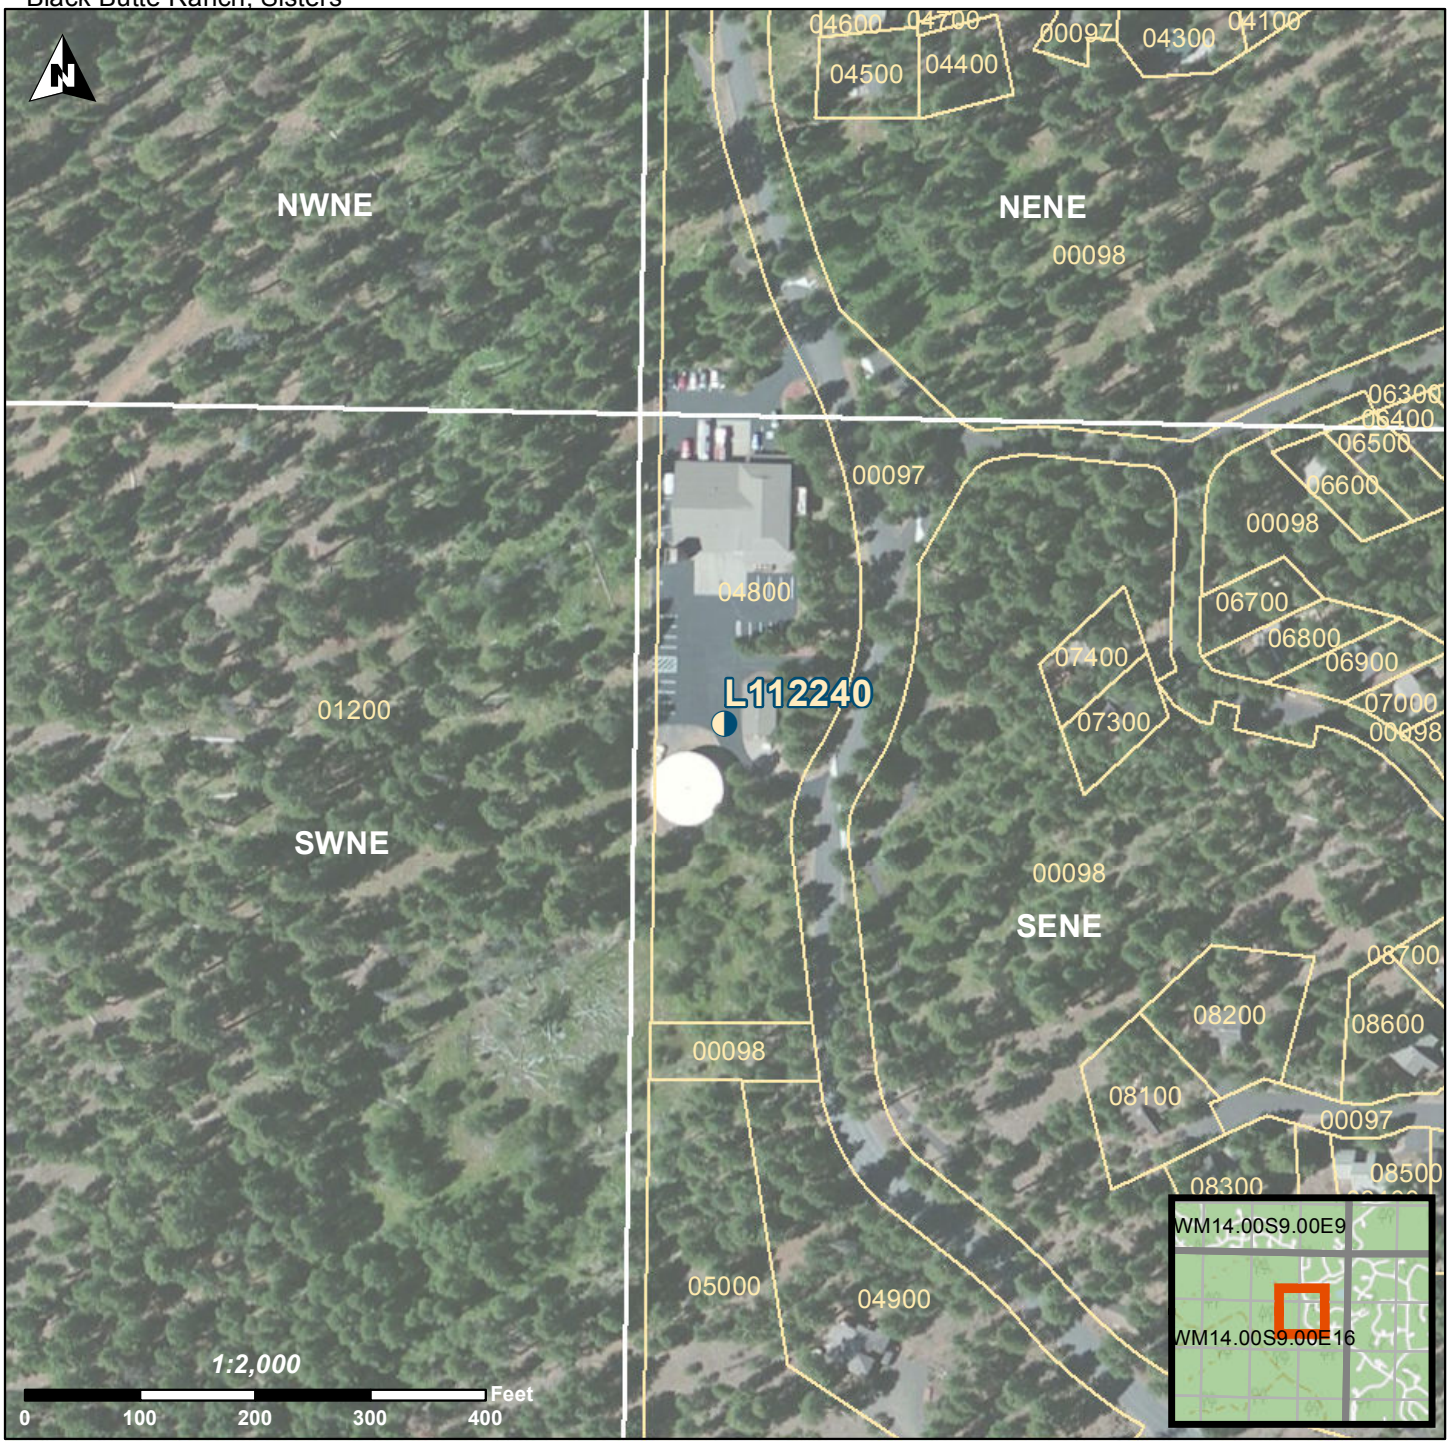
Provided by landowner